


41004
 Map No. K14 Sec. 6 Twp. 26 R. 5

Well No. 12 Barnhill Farm

Empire Company

NORTH

WEST

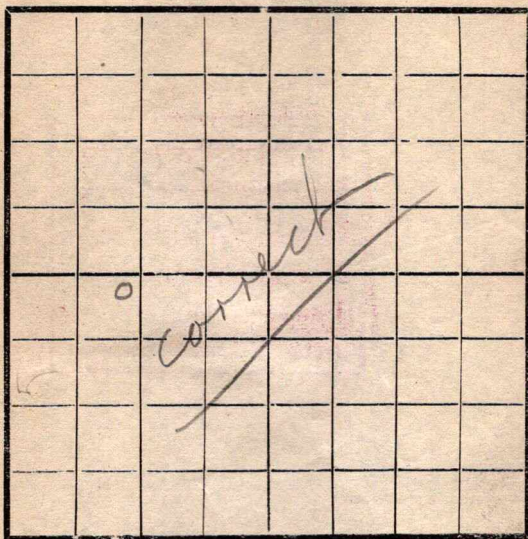

EAST

SOUTH

Location -----

Rig Up ☒ -----

Drilling and remarks

RECORD

Cased ----- in. ----- Ft.

Sand -----

Gas -----

Oil -----

Total Depth -----

PRODUCTION

1st 24 hrs. Nat. -----

1st 24 hrs. after shot -----

Gas ----- Cu. Ft.

Dry Hole -----

Abandoned -----

Date


1/5, 1918 S. D. Tyle Scout

Map No. _____ Sec. 4 Twp. 26 R. 5
Well No. 12 Barnhill Farm _____
Empire Company _____

NORTH

WEST

EAST

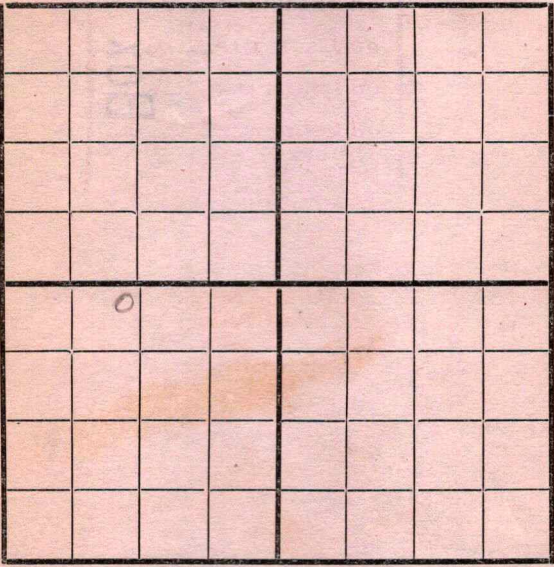

SOUTH

Location _____
Rig Up ✓ _____
Drilling and remarks _____

RECORD

Cased _____ in. _____ Ft.
Sand _____
Gas _____
Oil _____
Total Depth _____

PRODUCTION


1st 24 hrs. Nat. _____
1st 24 hrs. after shot _____
Gas _____ Cu. Ft.
Dry Hole _____
Abandoned _____

Date 1/10, 1918 Pyce Scout

Map No. _____ Sec. 16 Twp. 26 R. 5
 Well No. 12 Bearhill Farm
Empire Company

NORTH

WEST

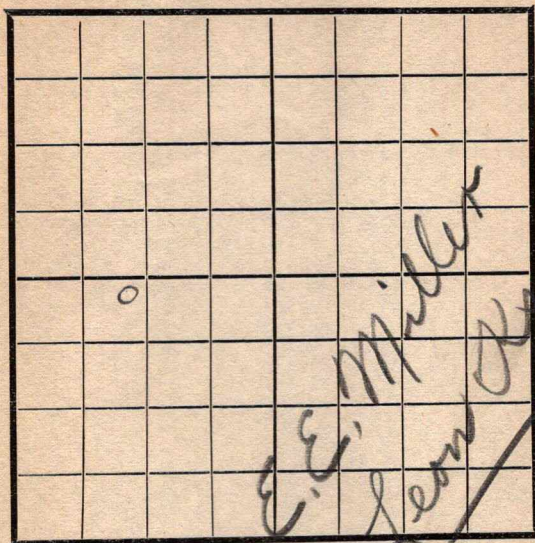

EAST

SOUTH

Location _____

Rig Up _____

Drilling and remarks

320

RECORD

Cased _____ in. _____ Ft.

Sand _____

Gas _____

Oil _____

Total Depth _____

PRODUCTION

1st 24 hrs. Nat. _____

1st 24 hrs. after shot _____

Gas _____ Cu. Ft.

Dry Hole _____

Abandoned _____


Date

2/27, 1918 Pyle Scout

Map No. _____ Sec. 6 Twp. 26 R. 5
 Well No. 12 Barnhill Farm
Empire Company

NORTH

WEST

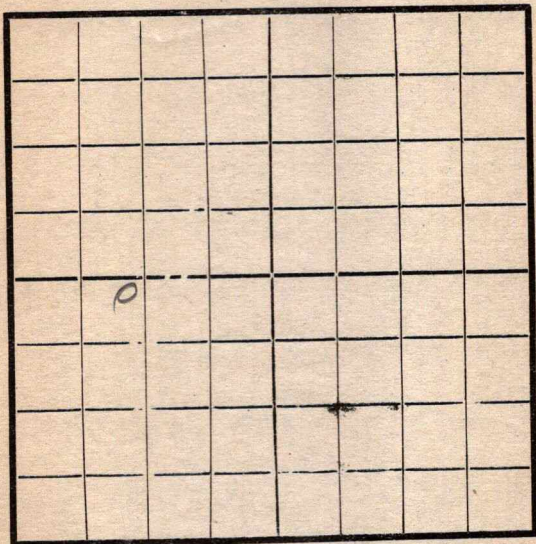

EAST

SOUTH

Location _____
 Rig Up _____
 Drilling and remarks

825'

RECORD

Cased _____ in. _____ Ft.
 Sand _____
 Gas _____
 Oil _____
 Total Depth _____

PRODUCTION

1st 24 hrs. Nat. _____
 1st 24 hrs. after shot _____
 Gas _____ Cu. Ft.
 Dry Hole _____
 Abandoned _____


Date

3/7, 1918 G. L. G. Scout

Map No. _____ Sec. 10 Twp. 26 R. 5
 Well No. 12 Barnhill Farm
Empire Company

NORTH

WEST

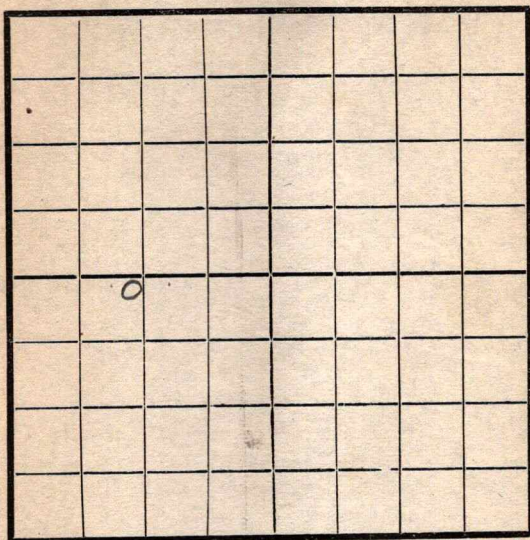

EAST

SOUTH

Location _____
 Rig Up _____
 Drilling and remarks

RECORD

Cased _____ in. _____ Ft.
 Sand _____
 Gas _____
 Oil _____
 Total Depth _____

PRODUCTION

1st 24 hrs. Nat. _____
 1st 24 hrs. after shot _____
 Gas _____ Cu. Ft.
 Dry Hole _____
 Abandoned _____


Date

3/12, 1918 Pyle Scout

Map No. _____ Sec. 6 Twp. 26 R. 5Well No. 12 Barnhill FarmEmpire Company

NORTH

WEST

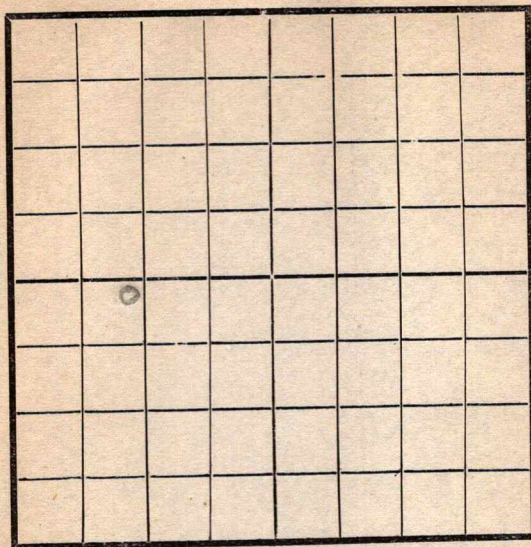

SOUTH

Location _____

Rig Up _____

Drilling and remarks

1335

RECORD

Cased _____ in. _____ Ft.

Sand _____

Gas _____

Oil _____

Total Depth _____

PRODUCTION

1st 24 hrs. Nat. _____

1st 24 hrs. after shot _____

Gas _____ Cu. Ft.

Dry Hole _____


Abandoned _____

Date

3/8, 1918 Pyle Scout

20

Map No. _____ Sec. 6 Twp. 26 R. 5
 Well No. 12 Barnhill Farm
Empire Company
 NORTH

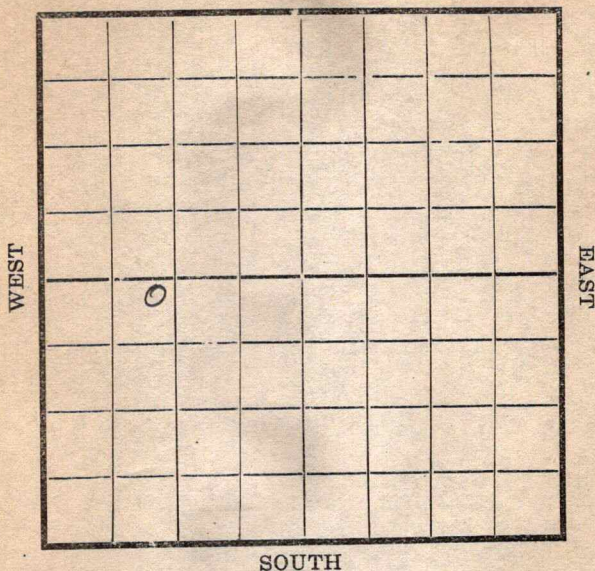

Location _____
 Rig Up _____
 Drilling and remarks _____

1645'

RECORD

Cased _____ in. _____ Ft.
 Sand _____
 Gas _____
 Oil _____
 Total Depth _____

PRODUCTION

1st 24 hrs. Nat. _____
 1st 24 hrs. after shot _____
 Gas _____ Cu. Ft.
 Dry Hole _____
 Abandoned _____

Date


3/27, 1918 Gyle Scout

Map No. _____ Sec. 6 Twp. 26 R. 5
Well No. 12 Barnhill Farm _____
Empire Company _____

NORTH

WEST

EAST

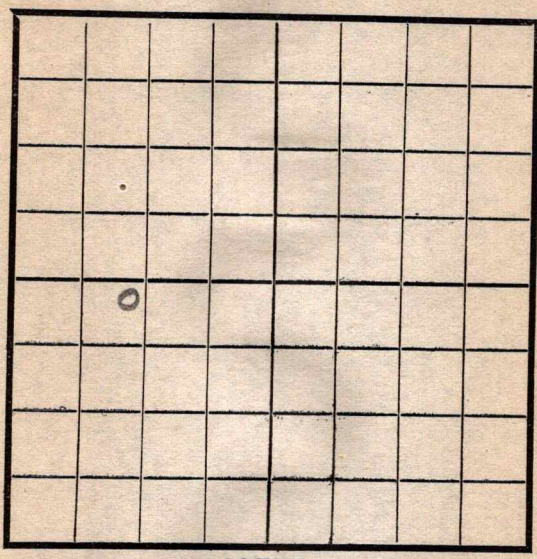

SOUTH

Location _____
Rig Up _____
Drilling and remarks _____

1832'

RECORD

Cased _____ in _____ Ft.
Sand _____
Gas _____
Oil _____
Total Depth _____

PRODUCTION


1st 24 hrs. Nat. _____
1st 24 hrs. after shot _____
Gas _____ Cu. Ft.
Dry Hole _____
Abandoned _____

Date 4/2, 1918 Cycle Scout

Map No. _____ Sec. 6 Twp. 26 R. 5
 Well No. 12 Barnhill Farm _____
Empire Company _____

NORTH

WEST

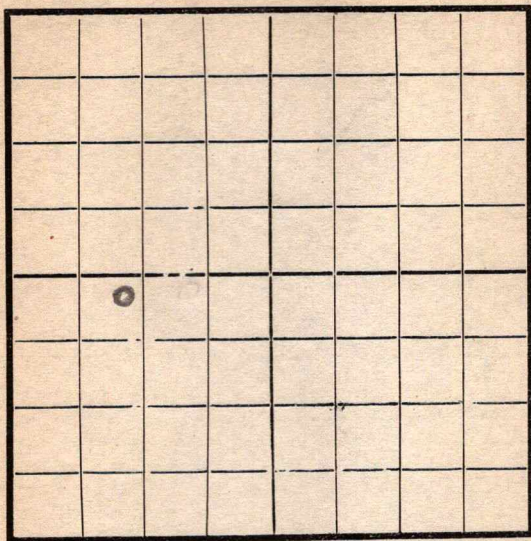

EAST

SOUTH

Location _____

Rig Up _____

Drilling and remarks

2000'

RECORD

Cased _____ in. _____ Ft.

Sand _____

Gas _____

Oil _____

Total Depth _____

PRODUCTION

1st 24 hrs. Nat. _____

1st 24 hrs. after shot _____

Gas _____ Cu. Ft.

Dry Hole _____

Abandoned _____


Date

4/8, 1918
10

Dyke

Scout

Map No. _____ Sec. 6 Twp. 26 R. 5
 Well No. 12 Barnhill Farm _____
Empire Company
 NORTH

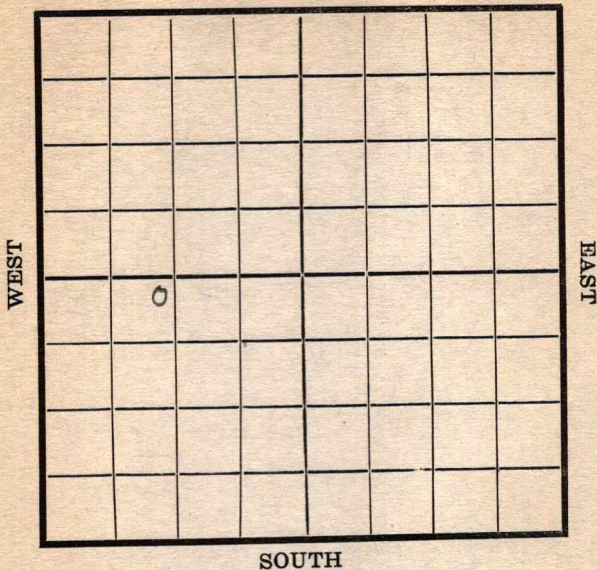

Location _____

Rig Up _____

Drilling and remarks

2140'

RECORD

Cased _____ in. _____ Ft.

Sand _____

Gas _____

Oil _____

Total Depth _____

PRODUCTION

1st 24 hrs. Nat. _____

1st 24 hrs. after shot _____

Gas _____ Cu. Ft.

Dry Hole _____

Abandoned _____


Date

4/17, 1918 Oyle Scout

Map No. _____ Sec. 6 Twp. 26 R. 5
 Well No. 12 Barnhill Farm _____
Empire Company _____

NORTH

WEST

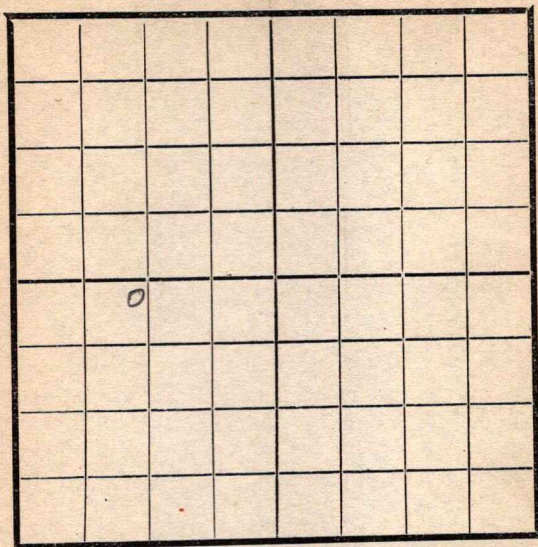

EAST

SOUTH

RECORD

Location _____

Cased _____ in. _____ F

Rig Up _____

Sand _____

Drilling and remarks

Gas _____

Oil _____

Total Depth _____

PRODUCTION

1st 24 hrs. Nat. _____

1st 24 hrs. after shot _____

Gas _____ Cu. F

Dry Hole _____

Abandoned _____

Date

4/24, 1918 _____ By _____
 _____ Score _____


*D. D. for pipe
 top sand 2435*

Map No. _____ Sec. 6 Twp. 26 R. 5
 Well No. 12 Barnhill Farm _____
Empire Company

NORTH

WEST

EAST

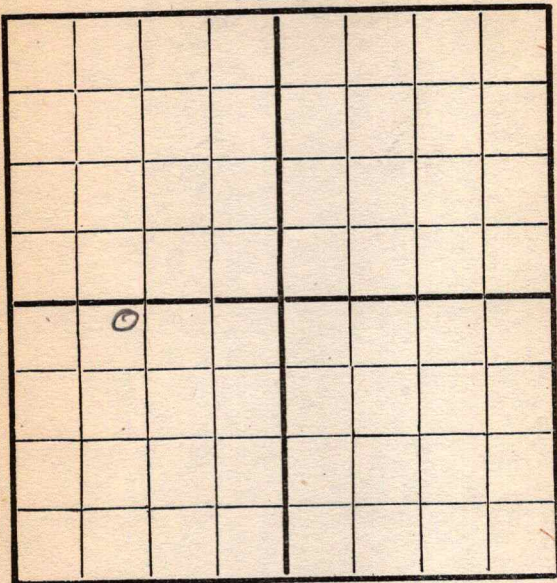

SOUTH

RECORD

Location _____
 Rig Up _____
 Drilling and remarks _____

Cased _____ in. _____ Ft.
 Sand _____
 Gas _____
 Oil _____
 Total Depth _____

2435' top D.
D 12 for
pipe.


PRODUCTION

1st 24 hrs. Nat. _____
 1st 24 hrs. after shot _____
 Gas _____ Cu. Ft.
 Dry Hole _____
 Abandoned _____

Date 5/2, 1918 Clyde Scout

Map No. _____ Sec. 6 Twp. 26 R. 5
 Well No. 12 Barnhill Farm
Empire Company

NORTH

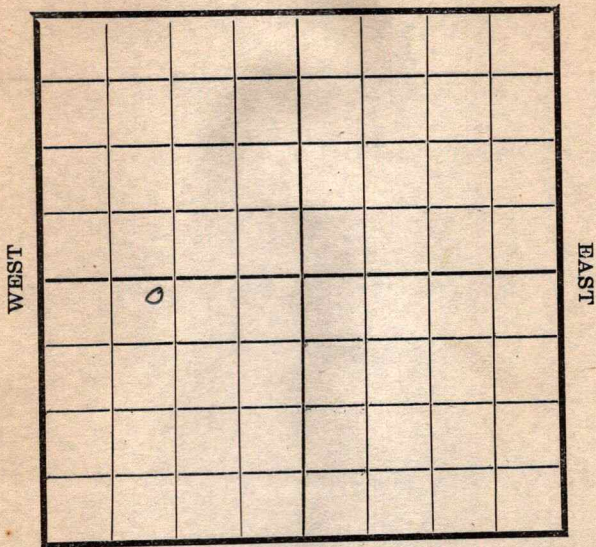

SOUTH

Location _____
 Rig Up _____
 Drilling and remarks

RECORD

Cased _____ in. _____ Ft.
 Sand _____
 Gas _____
 Oil _____
 Total Depth _____

PRODUCTION

1st 24 hrs. Nat. _____
 1st 24 hrs. after shot _____
 Gas _____ Cu. Ft.
 Dry Hole _____
 Abandoned _____

Date

5/8, 1918 C. L. C. L. Scout

Map No. _____ Sec. 6 Twp. 26 R. 5Well No. 12 Barnhill
Empire Company

Contractor _____

NORTH

WEST

EAST

SOUTH

RECORD

Location _____

Cased _____ in., _____ ft.

Rig up _____

Sand 2435-2490

Drilling and Remarks:

Gas _____

Oil _____

Total Depth _____

PRODUCTION

1st 24 hrs. Nat. _____

1st 24 hrs. after shot _____

Gas _____ Cu. Ft.

Dry Hole _____

Abandoned _____

Date

191


Scout

1004 R 14
 Map No. 14 Sec. 6 Twp. 26 R. 5
 Well No. 17 Barnhill
Empire Company
 Contractor

NORTH

WEST

EAST

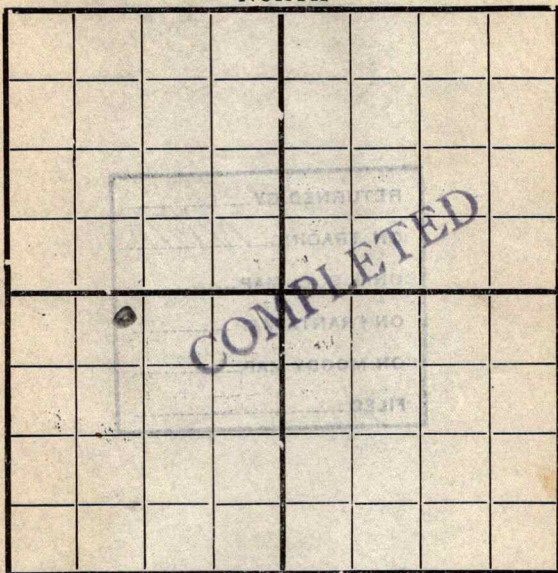

SOUTH

Location _____

Rig up _____

Drilling and Remarks:

RECORD

Cased _____ in., _____ ft.

Sand 2448-2492

Gas _____

Oil _____

Total Depth _____

PRODUCTION

1st 24 hrs. Nat. 50.6 bbls

1st 24 hrs. after shot _____

Gas _____ Cu. Ft.

Dry Hole _____


Abandoned _____

Date

191

Scout

2-35 Sec. 6, Twp 26 S, Range 5 E.

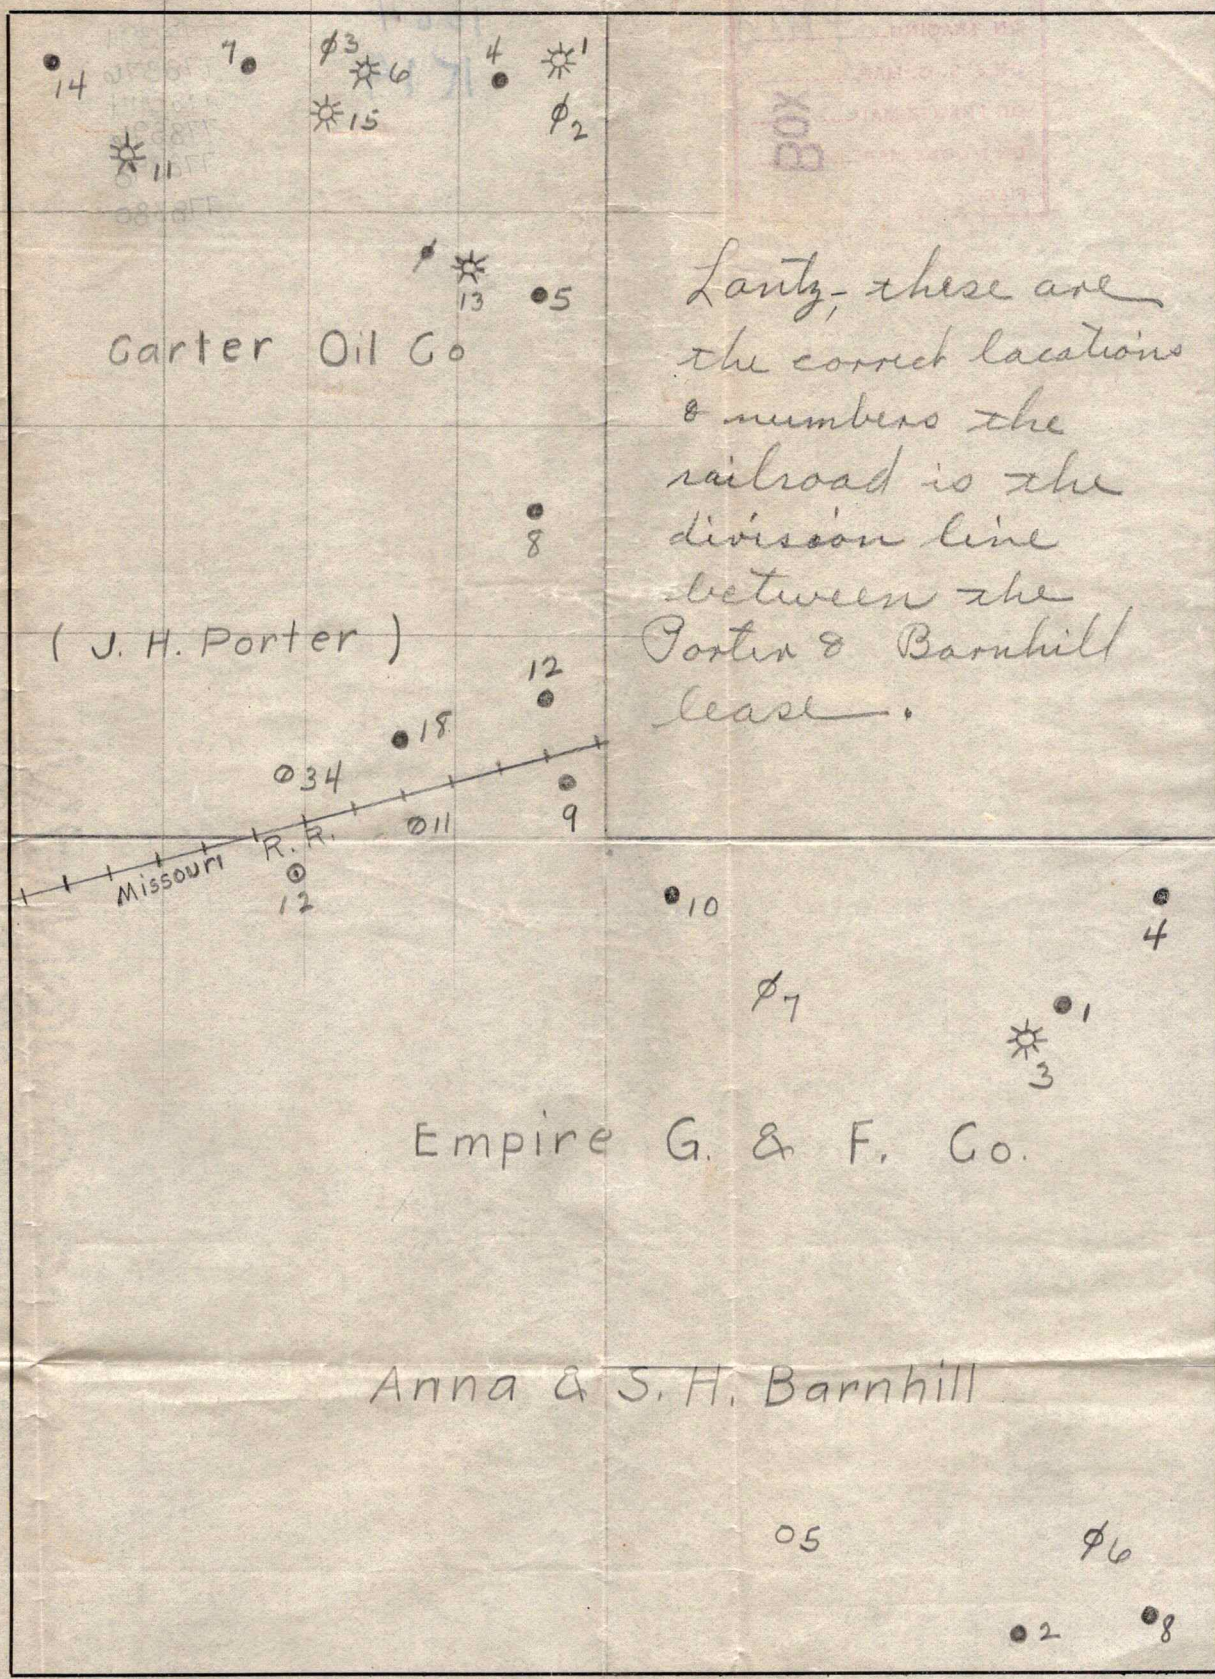

Lantz, these are the correct locations & numbers the railroad is the division line between the Porter & Barnhill lease.