

KANSAS

Well No. # 25 Hess

Company Cities Service Oil

NORTH

WEST

EAST

0

SOUTH

Butler

KANSAS

SEC.	TWP.	R.
18	26	5E

WELL NO.

#25 Hess

FARM

COMPANY

Cities Service Oil

CONTRACTOR

Ft. from N. Line

255


Ft. from S. Line

315

Ft. from E. Line

Ft. from W. Line

SE SE SW

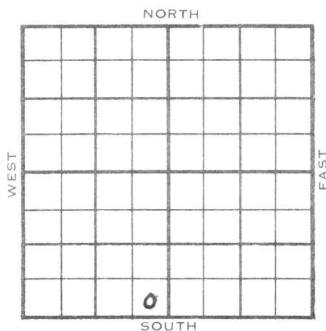

	ELEVATION	REPORT
1953	1327'	

9/16

Oil Well

TD 2528'

Lans 1748, KC 2012, B KC 2161, Viola
2498, Simp 2521

TD 2528'

5" @ 2526'


CO to 2519

64/ 2498-2514

Comp. waiting on water flood.

FIRST REPORT

COMPLETED

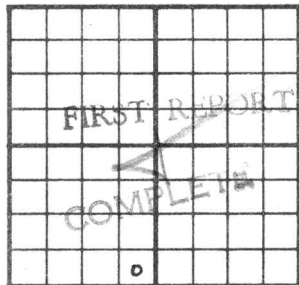County Butler State KansasSec. 18 (Blk. Twp.) 26 (Sur. Rge.) 5E Map No.Operator Cities Service OilWell No. 25 Farm HessElev. 1327 Location SE SE SW255 Ft. From S Line SW315 Ft. From E Line Quarter1st. Report SEP 16 1953Completion SEP 16 1953

Remarks

Spudding Date

Drlg. Data Oil well TD 2528Lans. 1748 KC 2012 B KC 2161Viola 2498 Simp. 2521 TD 25285" @ 2526 CO to 2519 64/ 2498-2514Comp. waiting on water flood