


Section 18 Township 26 Range 5 E
Well No. # 28 Hess
Company Cities Service

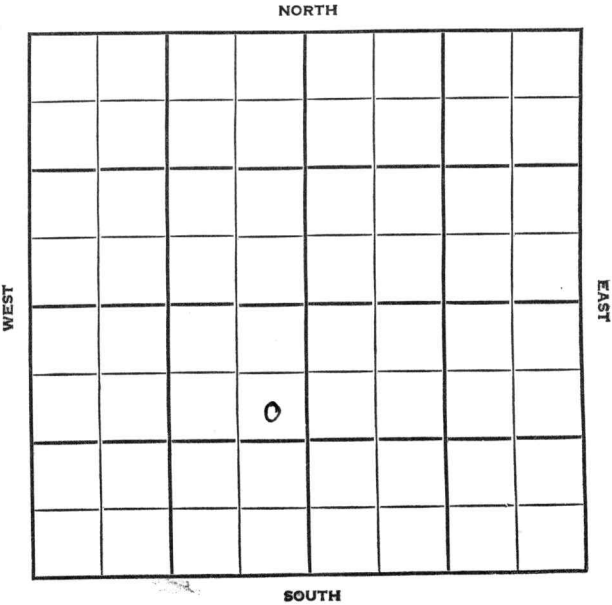

Butler KANSAS

SEC.	TWP.	R.
18	26	5 E

WELL NO.

28 Hess

FARM

COMPANY

Cities Service

CONTRACTOR

El Dorado Pool


1170 Ft. from N. Line

Ft. from S. Line

330 Ft. from E. Line

Ft. from W. Line

SE NE SW

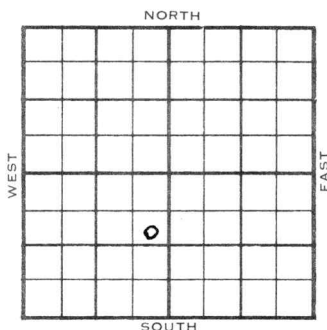

	ELEVATION	REPORT
1954	1164' RB	

5/26


Oil well TD 2592 Viola 2490

Simp. 2515' Arb. 2586'

7" @ 2587 TD 2588 DD 2592

P/77 BOPD Comp. 77 BOPD 10½ BW

**FIRST REPORT
COMPLETED**

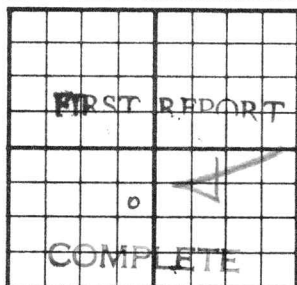County **Butler** State **Kansas**Sec. **18** (^{Blk.}
Twp.) **26** (^{Sur.}
Rge.) **5E** Map No.Operator **Cities Service**Well No. **28** Farm **Hess**Elev. **1164 RB** Location **SE NE SW****1170** Ft. From **N** Line **SW****330** Ft. From **E** Line Quarter1st. Report **MAY 26 1954**Completion **MAY 26 1954**Remarks **Eldorado Pool**

Spudding Date

Drlg. Data **Oil well** **TD 2592****Viola 2490** **Simp. 2515** **Arb. 2586****7" @ 2587** **TD 2588** **DD 2592** **P/ 77 bopd****Comp. 77 bopd** **10 $\frac{1}{2}$ bw**