


Section 18 Township 26 Range 5EWell No. #29 HessCompany C.S.O.

NORTH

WEST

EAST

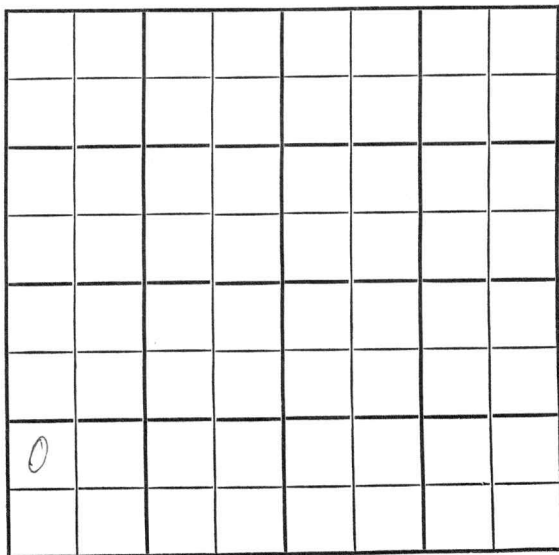

SOUTH

County Butler Elev. 1355
Sec. 18 Twp. 26 Rge. 5E
Company C. S. O.
FarmName Hess No. 29

TOPS	DEPTH	LOG	DATUM	Loc. in Sec.
Anh.				NW SW SW
TP.				
H.				
Tr.				
Dg.				
BL.				
L.	1842			Geol.
K.C.	2042			Contr.
B.K.C.	2260			
Ce.				
C.				
M.				
M.				Pool
K.				Eldorado
Mz.				
Me.				
V.	2531			
S.	2535			
S.				
A.				
R.				
PE.				
G.				
TD.	2572			

Date Comm. 7" @ 2566 w/150, TD 2609, P 11 BO /13
BW/15, P. O. COMPLETE

[Handwritten signature]