


Plotted by #11

Hoxley
County

Bett
Farm

No 1 - A

Dixie's Gas Co.
Company

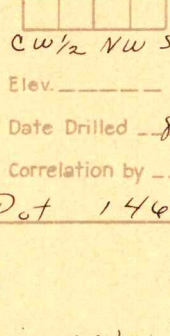

Twp.

6	5	4	3	2	1
X	8	9	10	11	12
18	17	16	15	14	13
19	20	21	22	23	24
30	29	28	27	26	25
31	32	33	34	35	36

CW 1/2 NW 5W

Elev. T.D. 3381

Date Drilled 8/15/39

Correlation by

Pot 146 B.

