DX 78-1

Harper

KANSAS

Section 22 Township 31 Range 8W

Well No. #1 Williams

Company Superior Oil

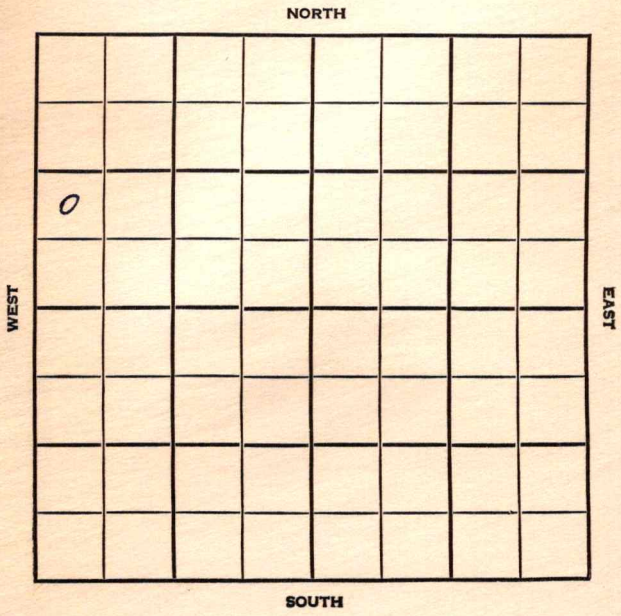

Harper KANSAS

| SEC. | TWP. | R. |
|---|---|---|
| 22 | 31 | 8W |

WELL NO. 1 Williams FARM

COMPANY Superior Oil

CONTRACTOR

Grabs Pool

_____ Ft. from N. Line

990 Ft. from S. Line

_____ Ft. from E. Line

330 Ft. from W. Line

NW SW NW

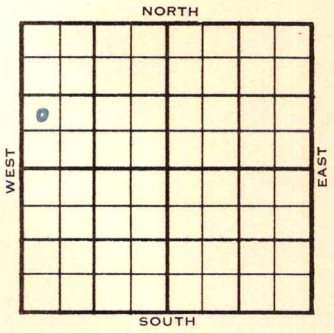


| 1955 | ELEVATION 1621' REPORT |
|---|---|
| 3/9 | Location |
| 6/8 | Comm 3-12-55<br>M 4423<br>TD 4476<br>10 3/4" @ 108/250 7" @ 4476/250<br>CO to 4462 40/4426-36 S/25 bf<br>15 hr 15% wtr frac F/39 bo 3 hr<br>F/6.4 bf 1 hr 40% wtr F/19.6 bf<br>2½ hr. ~~50~~ 40% wtr. S/171.76 bf 11 hr<br>S/42 bf 2½ hr 60% wtr P/55 bf<br>10% wtr 13 hr P/85 bf 60% wtr<br>P/86 bf 60% wtr 24 hr P/32 bf<br>60% wtr 9½ hr. SI 96 hr.<br>P/66 bf 55% wtr 18 hr P/47 bf<br>14 hr SI 96 hr Comp 81 bopd 31% wtr<br><br>COMPLETED |

DX-78

FORM 275 FOR SALE BY KANSAS BLUE PRINT CO.

County Harper State Kansas

Sec. 22 (Blk. Twp.) 31 (Sur. Rge.) 8W Map No.

Operator Superior Oil

Well No. 1 Farm Williams

Elev. Location NW SW NW

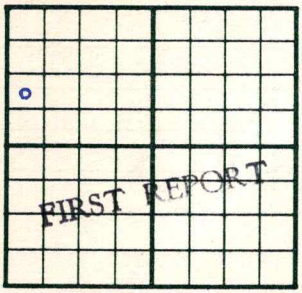


990 Ft. From S Line NW

330 Ft. From W Line Quarter

1st. Report MAR 9 1955

Completion

Remarks

Spudding Date

Drlg. Data Grabs Pool

Location

FABEN GILSTRAP

FORM 513 REV. SUNRAY

County Harper Elev. 1621

Sec. 22 Twp. 31 Rge. 8W

Company Superior Oil

Farm Name Williams No. 1

| TOPS | DEPTH | LOG | DATUM |
|---|---|---|---|
| Anh. | | | |
| T.P. | | | |
| H. | | | |
| Tr. | | | |
| Dg. | | | |
| B.L. | | | |
| L. | | | |
| K.C. | | | |
| B.K.C. | | | |
| Ce. | | | |
| C. | | | |
| M. | 4423 | | 2802 |
| M. | | | |
| K. | | | |
| Mz. | | | |
| Mc. | | | |
| V. | | | |
| S. | | | |
| S. | | | |
| A | | | |
| R. | | | |
| P€. | | | |
| G. | | | |
| T.D. | 4476 | | |

Loc. in Sec. NW SW NW

Geol.

Contr.

Pool Grabs




Date Comm. 3-12-55 JUN 8 1955

10 3/4" @ 108/250 7" @ 4476/250

CO to 4462 40/ 4426-36 S/ 25 bf 15 hr

15% wtr. frac F/ 39 bo 3 hr.

F/ 6.4 bf 1 hr. 40% wtr. F/ 19.6 bf

2½ hr. 40% wtr. S/ 171.76 bf 11 hr.

S/ 42 bf 2½ hr. 60% wtr. P/ 55 bf

10% wtr. 13 hr. P/ 85 bf 60% wtr.

P/ 86 bf 60% wtr. 24 hr. P/ 32 bf

OVER

Co. Lse. No. Sec. T. R.

60% wtr. 9½ hr. SI 96 hr.
P/ 66 bf 55% wtr. 18 hr. P/ 47 bf
14 hr. SI 96 hr. Comp. 81 bopd 31% wtr.

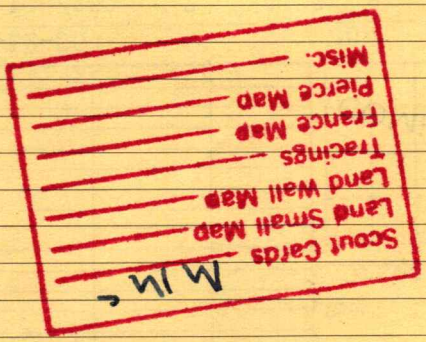


JUN 27 1955