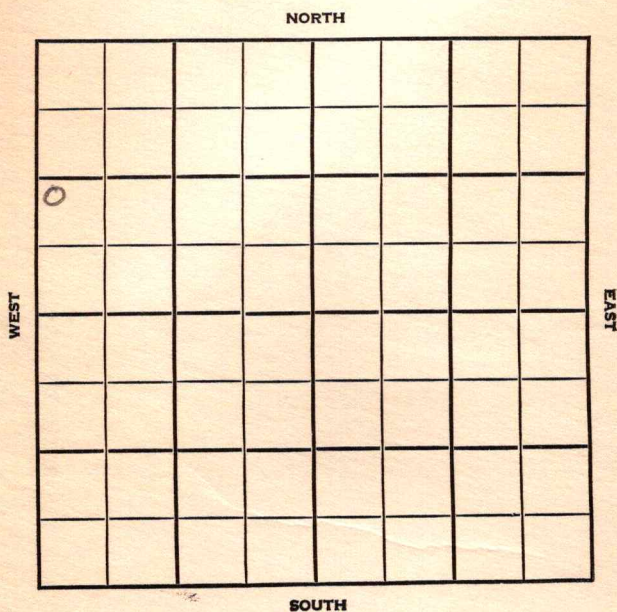


Harper

Section 21 Township 31 Range 8WWell No. #1 J. C. Burgess "B"Company Stanolind

Harper

KANSAS

SEC.	TWP.	R.
21	31	8 W

WELL NO.

1 J. C. Burgess "B"

FARM

COMPANY

Stanolind

CONTRACTOR

Iron Drlg.


Grabs

_____ Ft. from N. Line

_____ Ft. from S. Line

_____ Ft. from E. Line

_____ Ft. from W. Line

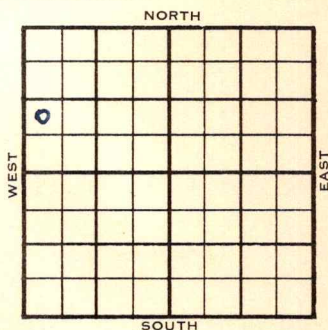

NW SW NW

ELEVATION

1592'

REPORT

1955

6/8

Comm. 6-5-55

8" @ 214/250 WOC

DS. 4388-4403 open 1 hr. gas in 23 min. Rec.
 150' ho & gcm 100' ho & gcw 20' sw
 1285# 5½" @ 4424/200 CO to 4405 12/4389
 91, 4½ go ½ gwph 200A S/½ bo 500 A fra
 S/7 3/4 bfph 86% wtr. 5 hr. doc-treat-
 ment 4389-91 200 bo S/3 bfph 76% wtr.
 S/5 bfph 94% wtr 8 hr. 4/4389-90 2 go
 ½ gwph 6 hr. 250A 1¼ bo ½ bwph, Comp
 21 bopd 30% wtr.

Tops:	Depth	Datum
L.	3633	2041
M.	4288	2796
TD	4425	

COMPLETED

County Harper ✓ Elev. _____
Sec. 21 Twp. 31 Rge. 8W
Company Stanolind
Farm Name J. C. Burgess "B" No. 1

TOPS	DEPTH	LOG	DATUM	Loc. in Sec. _____
Anh.				<u>NW SW NW</u>
Tp.				
H.				
Tr.				
Dg.				
Bl.				
L.				
K.C.				Geol. _____
B.K.C.				Contr. _____
Ce.				
C.				<u>Iron Drlg.</u>
M.				
M.				Pool _____
K.				
Mz.				<u>Grabs</u>
Mq.				
V.				
S.				
S.				
A.				
R.				
Pe.				
G.				
T.D.				

0

FIRST REPORT

JUN 8 55

Date Comm. 6-5-55
8" @ 214/250 WOC

1 < 27

County Harper Elev. 1592
 Sec. 21 Twp. 31 Rge. 8W
 Company Stanolind
 Farm Name J. C. Burgess "B" No. 1

Co.

TOPS

DEPTH

LOG

DATUM

Loc. in Sec.

Anh.

Tp.

H.

Tr.

Dg.

Bl.

L.

K.C.

B.K.C.

Ce.

C.

M.

M.

K.

Mz.

Mq.

V.

S.

S.

A.

R.

P.E.

G.

T.D.

3633

2041

Geol.

Contr.

Iron Drlg.

Pool

Grabs

COMPLETE

Lse.

No.

Sec.

T.

R.

Date Comm. 6-5-55 JUL 20 1955
8" @ 214/250 DST 4388-4403 open 1 hr.

gas in 23 min. Rec. 150' ho & gcm

100' ho & gcw 20' sw 1285# 5½" @

4424/200 CO to 4405 12/ 4389-91

4½ go ½ gwph 200 A S/ ½ bo

500 A frac S/ 7 3/4 bfph 86% wtr.

5 hr. doc-treatment 4389-91 200 bo

S/ 3 bfph 76% wtr. S/ 5 bfph 94% wtr.

OVER

8 hr. 4/ 4389-90 2 go $\frac{1}{2}$ gwph 6 hr.
250 A $1\frac{1}{4}$ bo $\frac{1}{2}$ bwph
Comp. 21 bopd 30% wtr.

Scout Cards	
Land Small Map	
Land Wall Map	
Tracings	
France Map	
Pierce Map	
Misc.	

8c

JUL 27 1955