


Section 21 Township 31 Range 8W
Well No. #1 Burgess "A"
Company Stanolind.

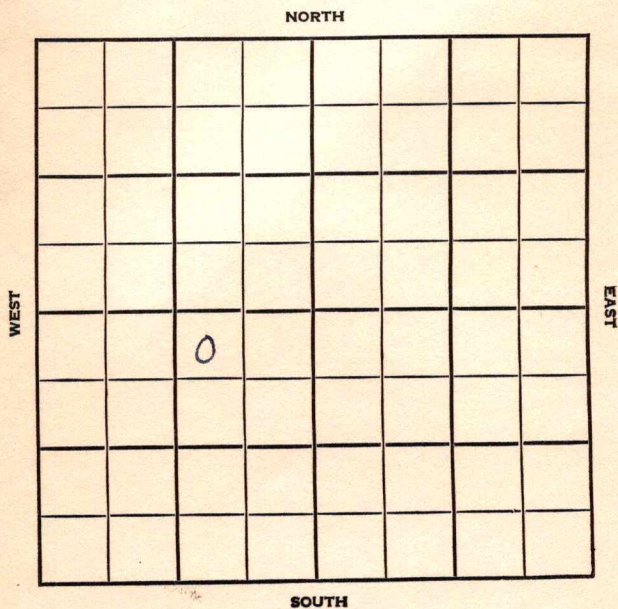

Harper		
SEC.	TWP.	R. KANSAS
21	31	8W
WELL NO. #1 Burgess "A"		
FARM		
COMPANY Stanolind		
CONTRACTOR		

Grabs Pool


330 Ft. from N. Line

Ft. from S. Line

990 Ft. from E. Line

Ft. from W. Line

NW NE SW

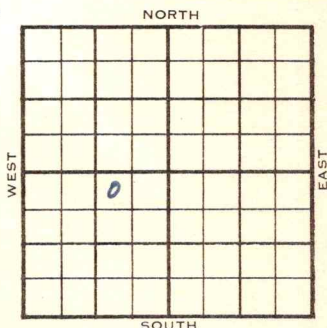

1955	ELEVATION	REPORT
	1578	

4/6 Location

6/8 Comm 4-10-55
L 3607, M 4379, TD 4464
 8 5/8" @ 211/250
 DST 4379-4404, open 1 hr Rec 150'
 o & gcm 240' smgco 30' sw 1335#
 DST 4404-29 open 1 hr Rec 150' so &
 gcmw 180' o & gcsw 270' sw 270/30"
 DST 4429-39 open 1 hr Rec 660'
 sw 1580# 5 1/2" @ 4462/200 CO to 4438
 20/4381-86 1 go 1 gswph 5 hr 500 A
 S/2 1/4 bo 2 3/4 bwph 5 hr ftac
 S/16 bo 12 bwph 6 hr Comp 17 bopd
 87% wtr.

COMPLETED

County Harper State KansasSec. 21 (Blk.
Twp.) 31 (Sur.
Rge.) 8W Map No.Operator StanolindWell No. 1 Farm Burgess "A"Elev. Location NW NE SW

330 Ft. From N Line SW990 Ft. From E Line Quarter1st. Report APR 6 1955

Completion

Remarks

Spudding Date

Drilg. Data Grabs PoolLocation

FABEN GILSTRAP

County Harper ✓ Elev. 1578
 Sec. 21 Twp. 31 Rge. 8W
 Company Stanolind
 Farm Name Burgess "A" No. 1

TOPS	DEPTH	LOG	DATUM
Anh.			
TP.			
H.			
Tr.			
Dg.			
Bl.			
L.	<u>3607</u>		<u>2029</u>
K.C.			
B.K.C.			
Ce.			
C.			
M.	<u>4379</u>		<u>2801</u>
M.			
K.			
Mz.			
Mq.			
V.			
S.			
S.			
A.			
R.			
PE.			
G.			
T.D.	<u>4464</u>		

Loc. in Sec. _____

NW NE SW

Geol. _____

Contr. _____

Barbour

Pool _____

Grabs

COMPLETE

Date Comm. 4-10-55

JUN 8 1955

8 5/8" @ 211/250 DST 4379-4404open 1 hr. Rec. 150' o & gcm 240' smgco30' sw 1335# DST 4404-29 open 1 hr.Rec. 150' so & gcmw 180' o & gcs w270' sw 270/30" DST 4429-39 open 1 hrRec. 660' sw 1580# 5 1/2" @ 4462/200CO to 4438 20/ 4381-86 1 go 1 gswph5 hr. 500 A S/ 2 1/4 bo 2 3/4 bwph 5 hr

OVER

frac S/ 16 bo 12 bwph 6 hr.

Comp. 17 bopd 87% wtr.

