O.W.W.O.


FORM 51 Barton

KANSAS

Section 23 Township 20 Range 12W

Well No. 2 ~~#1~~ Johnson

Company Lewis Drlg. Company

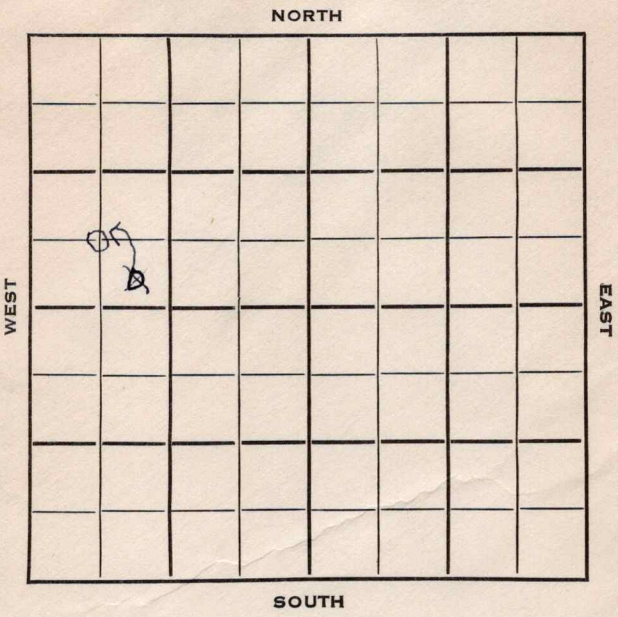

FORM 282-B

O.W.W.O. Barton

KANSAS

Sec. 23 Twp. 20 R. 12W

Well No. #2 ~~#1~~ Johnson Farm

Lewis Drlg. Company

Lewis Drlg. - Contr. Contractor

Chase-Silica Pool


Ft. from N. Line

660
~~330~~ Ft. from S. Line

Ft. from E. Line

660
~~990~~ Ft. from W. Line

C
~~SE~~ SW NW

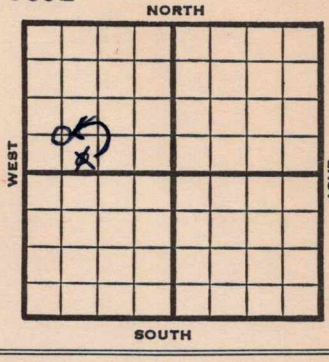

1953 Elev. 1815' REPORT

3/4 Spudded 3/3/52

3/12 8" @ 173
Drlg. 1970

3/18 Spud 3-3-53
D&A
TD 3400
8" @ 173
Heeb 3004, Br lime 3130, Lans 3145
DST 3153-84, opn ½ hrs., rec. 10' mud, 0#
Arb. 3392
TD 3400
D&A

ABANDONED

O.W.W.O.

1953
10/28 KC 3145' Arb. 3392' TD 3400
DD 3405' 5" @ 3400

12/16 No report

1954
1/13 Oil well TD 3405' Lans. 3130'
Cong. 3366' Arb. 3373' TD 3405'
CO to 3399' 81/3382-90 1000 A
S/10½ GO 1½ GW PB 3378
60/3372-78 1000 A S/21 GO

OVER

743174

1954
1/13 (Information continued)
CO to 3399 Frac. 1¼ BOPH 8 hr.
S/1 BOPH
Comp. 10 BOPD

COMPLETED

FORM 275 FOR SALE BY KANSAS BLUE PRINT CO.


County Barton State Kansas

Sec. 23 (Blk. Twp.) 20 (Sur. Rge.) 12W Map No.

Operator Lewis Drlg.

Well No. 1 Farm Johnson

Elev. Location SE SW NW

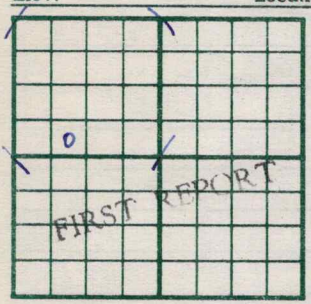

330 Ft. From S Line NW

990 Ft. From W Line Quarter

1st. Report MAR 4 1953

Completion

Remarks Lewis Drlg. - Contr.

Spudding Date 3-3-52

Drlg. Data

J. G. McGEHEE

FORM 275 FOR SALE BY KANSAS BLUE PRINT CO.


County Barton State Kansas

Sec. 23 (Blk. Twp.) 20 (Sur. Rge.) 12W Map No.

Operator Lewis Drlg.

Well No. 1 Farm Johnson

Elev. 1815 Location SE SW NW

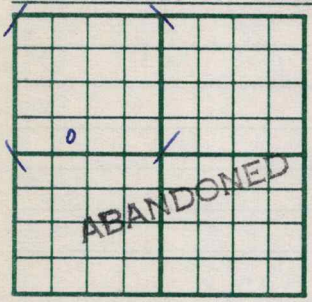

330 Ft. From S Line NW

990 Ft. From W Line Quarter

1st. Report

Completion MAR 1 8 1953

Remarks

Lewis Drlg. - Contr.

Spudding Date 3-3-52

Drlg. Data D & A TD 3400

8" @ 173 Heeb. 3004 Br. lime 3130

Lans. 3145 DST 3153-84 open ½ hr.

Rec. 10' mud 0# Arb. 3392 TD 3400

D & A

J. G. McGEHEE

FORM 275 FOR SALE BY KANSAS BLUE PRINT CO.

O.W.W.O.


County Barton State Kansas

Sec. 23 (Blk. Twp.) 20 (Sur. Rge.) 12W Map No.

Operator Lewis Drlg.

Well No. 1 Farm Johnson

Elev. 1815 Location SE SW NW

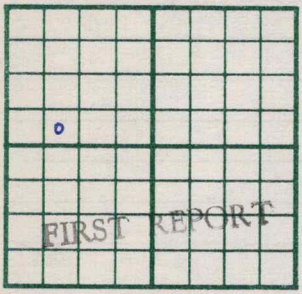

330 Ft. From S Line NW

990 Ft. From W Line Quarter

OCT 28 1953

1st. Report

Completion

Remarks CWWO

O.W.W.O.

Spudding Date

Drlg. Data Chase-Silica Pool

KC 3145 Arb. 3392 TD 3400 DD 3405

5" @ 3400

J. G. McGEHEE

FORM 26 200 BKS. 4-52 PETROL

Kansas

Map No. _____ Sec. 23 Twp. 20 R. 12W


Well No. 2 Johnson (was #1 Johnson)

Lewis Drlg. (was J.H.Hershey) Company

CORRECTION Contractor

C SW NW

SECTION PLAT

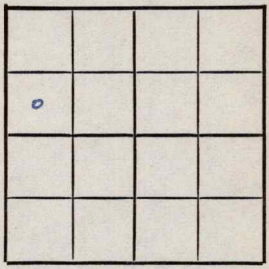

_____ Ft. from N. Line

660 Ft. from S. Line

_____ Ft. from E. Line

660 Ft. from W. Line

Barton County

Location _____

Rig up _____

Drilling and Remarks:

Reported
#1 Johnson

RECORD

Cased _____ in., _____ ft.

Sand _____

Gas _____

Oil _____

Total Depth _____

PRODUCTION

1st 24 hrs. Nat. _____

1st 24 hrs. after shot _____

Gas _____ Cu. Ft.

Dry Hole _____

Abandoned _____

Date

JAN 13 1954

19 _____

J. G. McGEHEE Scout

FORM 275 FOR SALE BY KANSAS BLUE PRINT CO.

O.W.W.O.

County Barton State Kansas

Sec. 23 (Blk. Twp.) 20 (Sur. Rge.) 12W Map No.

Operator Lewis D. Ilg. (was J. H. Hershey)

Well No. 2 Farm Johnson (was #1 Johnson)

Elev. 1815 Location C SW NW



660 Ft. From S Line NW

660 Ft. From W Line Quarter

1st. Report

Completion JAN 13 1954

Remarks OWWO

Spudding Date O.W.W.O.

Drlg. Data Oil well TD 3405

Lans. 3130 Cong. 3366 Arb. 3373

TD 3405 CO to 3399 81/ 3382-90

1000 A S/ 10½ go 1½ gw PB 3378

60/ 3372-78 1000 A S/ 21 go CO to 3399

frac 1¼ boph 8 hr. S/ 1 boph

Comp. 10 bopd

J. G. McGEHEE