
FORM 51 25M 8-50 WESTERN Stafford KANSAS

Section 8 Township 21 Range 13W

Well No. #1 Reed

Company Westgate-Greenaland

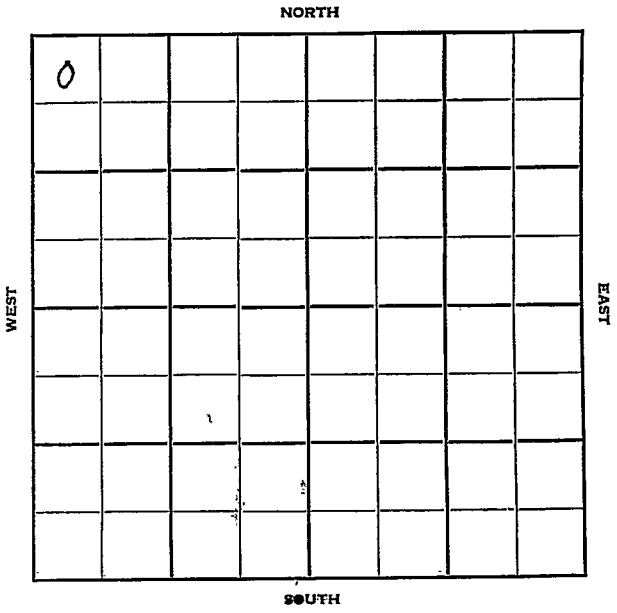

FORM 252-B
10M 11-50 PETROL

Stafford KANSAS

Sec. 8 Twp. 21 R. 13W

Well No. #1 Reed Farm

Westgate-Greenland Company

Jackson Drlg. - Contr. Contractor


330' Ft. from N. Line

Ft. from S. Line

Ft. from E. Line

330' Ft. from W. Line

NW NW NW

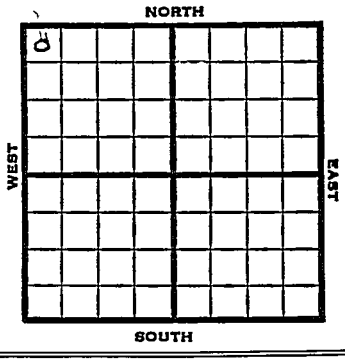

1951	Elev. 1907' REPORT
5/23	RUR-
8/8	Spud 5-23-51 Oil well TD 3615' 8" @ 217 Anhy 800' lost hole @ 3447' Skid 50' south 8" @ 322' Heeb 3184' Br. lime 3301' Lans. 3312' DST 3430-45' open 1 hr. rec 40' OCM DST 3450-82' open 1 hr. rec 150' O &GCM B KC 3534' Simp. 3558' Arb. 3579' DST 3579-84 open 1 hr. rec 1750' oil TD 3615' 5" @ 3615' 24/3583-3600 S/ 35 BOPH Comp. 732 BOPD COMPLETED

FORM 275 FOR SALE BY KANSAS BLUE PRINT CO.


County Stafford State Kansas

Sec. 8 (Blk. Twp.) 21 (Sur. Rge.) 13W Map No.

Operator Westgate-Greenland

Well No. 1 Farm Reed

Elev. Location NW NW NW

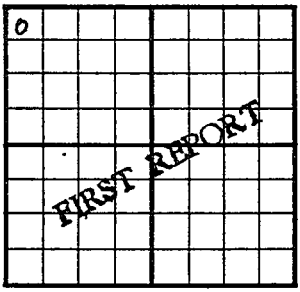

330 Ft. From N Line NW

330 Ft. From W Line Quarter

1st. Report MAY 23 1951

Completion

Remarks Jackson Drlg. - Contr.

Spudding Date

Drlg. Data

R U R

J. E. TYRA

FORM 275 FOR SALE BY KANSAS BLUE PRINT CO.


County Stafford State Kansas

Sec. 8 (Blk. Twp.) 21 (Sur. Rge.) 13W Map No.

Operator Westgate-Greenland

Well No. 1 Farm Reed

Elev. 1907 Location NW NW NW

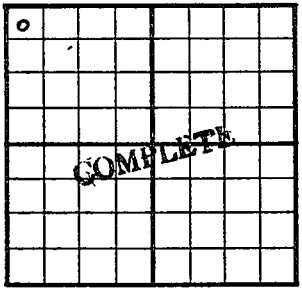

330 Ft. From N Line NW

330 Ft. From W Line Quarter

1st. Report

Completion AUG 8 1951

Remarks Jackson Drlg. - Contr.

Spudding Date 5-23-51

Drlg. Data Oil well TD 3615

8" @ 217 Anhy 800 lost hole @ 3447

Skid 50' south 8" @ 322 Heeb. 3184

Br. lime 3301 Lans. 3312 DST 3430-45

open 1 hr. Rec. 40' ocm DST 3450-82

open 1 hr. Rec. 150' o & gcm B KC 3534

Simp. 3558 Arb. 3579 DST 3579-84

open 1 hr. Rec. 1750' oil TD 3615

5" @ 3615 24/ 3583-3600 S/ 35 boph

Comp. 732 bopd

J. E. TYRA