


Map No. K 14 Sec. 6 Twp. 26 R. 5Well No. 15 Barnhill FarmEmpire Company

NORTH

WEST

EAST

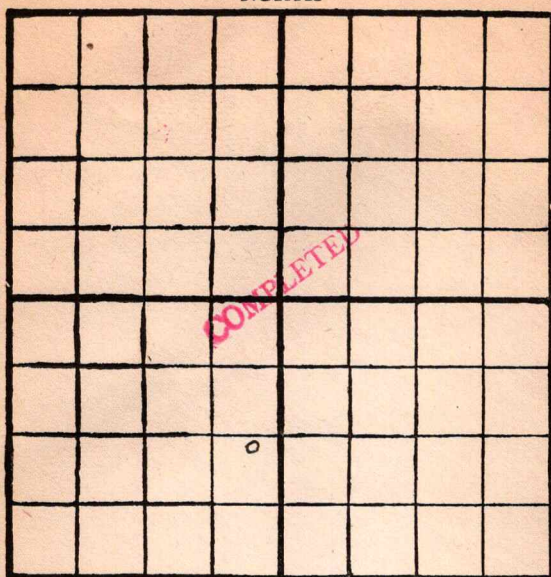

SOUTH

Location 1242 S. 293 E.

Rig Up _____

Drilling Remarks:

Drilling Remarks:

RECORD

Cased _____ in. _____ ft.

Sand _____

Gas _____

Oil _____

Total Depth _____

PRODUCTION

1st 24 hrs. Nat. _____

1st 24 hrs. after shot _____

Gas _____ cu. ft.

Dry Hole _____

Abandoned _____

Map No. K14 Sec. 6 Twp. 26 R. 5
 Well No. 15 Barnhill
Empire Company
 Contractor

NORTH

WEST

EAST

FIRST REPORT

SOUTH

1242 S 293 E

Location _____

Rig up. ☒

Drilling and Remarks:

RECORD

Cased _____ in., _____ ft.

Sand _____

Gas _____

Oil _____

Total Depth _____

PRODUCTION

1st 24 hrs. Nat. _____

1st 24 hrs. after shot _____

Gas _____ Cu. Ft.

Dry Hole _____

Abandoned _____

Date

Feb 13 1919 Pyle Scout

Map No. K14 Sec. 6 Twp. 26 R. 5
Well No. 15 Barnhill
Empire _____ Comban _____
_____ Contracto _____

NORTH

WEST

EAST

SOUTH

293 E

12425

Location _____

Rig up _____

Drilling and Remarks:

RECORD

Cased _____ in., _____ f

Sand _____

Gas _____

Oil _____

Total Depth.....

PRODUCTION

1st 24 hrs. Nat. -----

1st 24 hrs. after shot-----

Gas_____Cu. F

Dry Hole.....

Abandoned.....

Date _____

3/8 191 9

Pyle

Scott

Map No. K14 Sec. 16 Twp. 26 R. 5Well No. 15 BarnhillEmpire Company

Contractor

NORTH

WEST

EAST

COMPLETED

SOUTH

12425293 E

Location

Rig up

Drilling and Remarks:

RECORD

Cased _____ in., _____ ft.

Sand 2430-2470

Gas _____

Oil _____

Total Depth _____

PRODUCTION

1st 24 hrs. Nat. 145 bbls

1st 24 hrs. after shot _____

Gas _____ Cu. Ft.

Dry Hole _____

Abandoned _____

Date

5/20

191

9Cyle

Scout