


Map No. _____ Sec. 6 Twp. 26 R. 5
 Well No. 19 Barnhill Farm _____
Empire Company _____

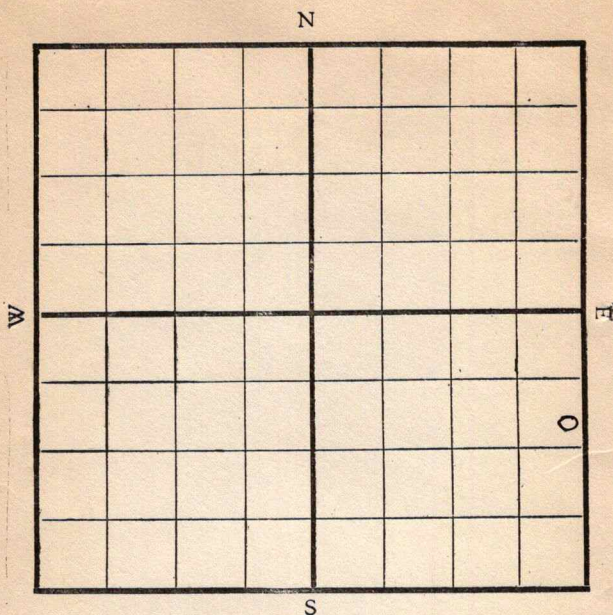

Location _____

Rig Up _____

Drilling Remarks:

Drilling Remarks:

COMPLETED

RECORD

Cased _____ in. _____ ft.

Sand _____

Gas _____

Oil _____

Total Depth _____

PRODUCTION

1st 24 hrs. Nat. _____

1st 24 hrs. after shot _____


Gas _____ cu. ft.

Dry Hole _____

Abandoned _____

Map No. _____ Sec. 6 Twp. 26 R. 5
 Well No. 19 Barnhill Farm _____
Empire Company _____

825 Ft. from N. Line
 _____ Ft. from S. Line
192 Ft. from E. Line
 _____ Ft. from W. Line

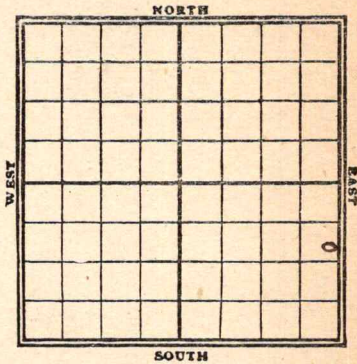

1919 Date	REPORT FIRST REPORT
2/5	Drl 2185'
1/17/20	Dr for 8" 2185'
4/3	Sand 2462-68-123 6000

COMPLETED

Map No. K14 Sec. 6 Twp. 26 R. 5Well No. 19 BarnhillEmpire Company

Contractor

SECTION PLAT

825 Ft. from N. Line

Ft. from S. Line

192 Ft. from E. Line

Ft. from W. Line

FIRST REPORT

Location

Rig up

Drilling and Remarks:

1069 2185

RECORD

Cased _____ in., _____ ft

Sand _____

Gas _____

Oil _____

Total Depth _____

PRODUCTION

1st 24 hrs. Nat. _____

1st 24 hrs. after shot _____

Gas _____ Cu. Ft

Dry Hole _____

Abandoned _____

Date

12/5 1919

Pyle

Scout

Map No. K 14 Sec. 6 Twp. 26 R. 5
Well No. 19 Barnhill
Empire Company
Contractor

SECTION PLAT

825 Ft. from N. Line
Ft. from S. Line
192 Ft. from E. Line
Ft. from W. Line

Location
Rig up
Drilling and Remarks:

RECORD


Cased in., ft.
Sand 2462-68
Gas
Oil
Total Depth

PRODUCTION

1st 24 hrs. Nat. 123 bbls
1st 24 hrs. after shot
Gas Cu. Ft.
Dry Hole
Abandoned

Date 4/3 1920 Pyle Scout

Map No. K 14 Sec. 16 Twp. 26 R. 5
 Well No. 19 Bamhill Farm
Empire Company
 Date Started _____ Ft. from N 790 S 192 W line
 NORTH

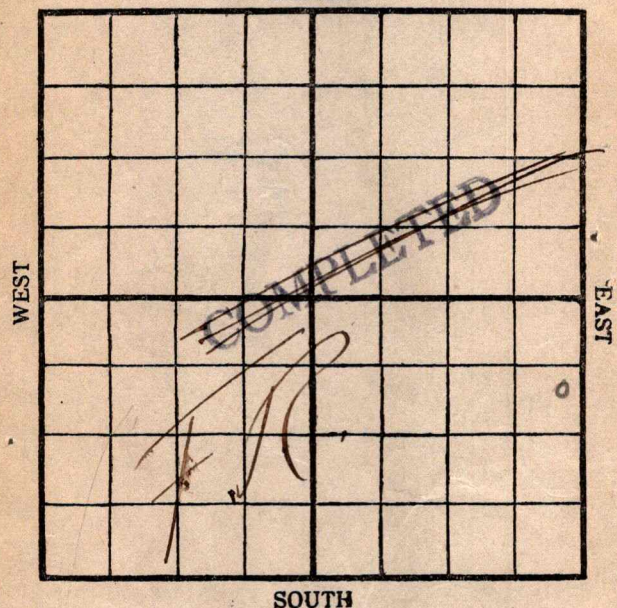

Cased _____ In. _____ Ft.		Production Remarks <u>S. D @ 1310</u>
Sand _____		
Pay {	Gas _____	
	Oil _____	
Total Depth _____		

Condition of Well on this date _____

This was No 16.
Change to No 19.
4/8
Pyle
 Scout