

N

A

四

S

Rig Up -----

Drilling Remarks:

PRODUCTION

1st 24 hrs. Nat.-----

1st 24 hrs. after shot-----

Gas ----- cu. ft.

Dry Hole -----

Abandoned -----

Map No. K14 Sec. 6 Twp. 26 R. 5


Well No. 20 Bamhler Farm
Engine Company

_____ Ft. from N. Line

330 Ft. from S. Line

330 Ft. from E. Line

_____ Ft. from W. Line

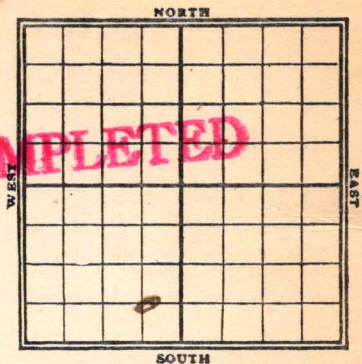

Date

REPORT

5/17
8/4

Ris up
2416-72


FIRST REPORT

100 lbs.

L 1004 K14 Map No. Sec. 6 Twp. 26 R. 5

Well No. 20 Barnhill Farm
Empire Company.

NORTH

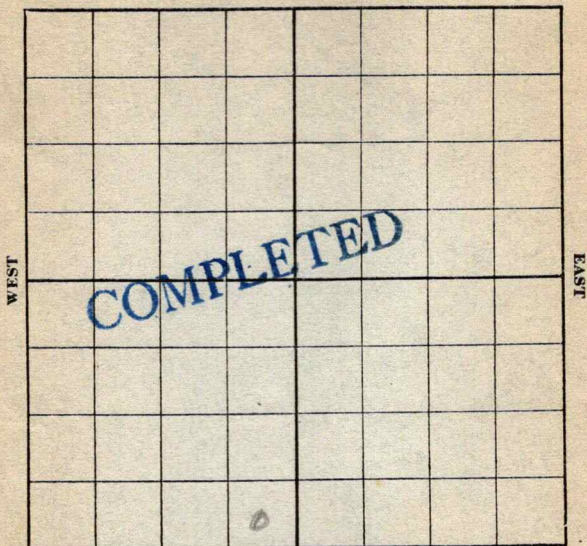

330 S-E

SOUTH

RECORD

Location -----

Cased ----- in., ----- ft.

Rig up -----

Sand 2416-72 -----

Drilling and Remarks:

Gas -----

Oil -----

Total Depth -----

PRODUCTION

1st 24 hrs. Nat. 100 bbls -----

1st 24 hrs. after shot -----

Gas ----- Cu. Ft.

Dry Hole -----

Abandoned -----

Date

7/4

1920

Pyle

Scout.