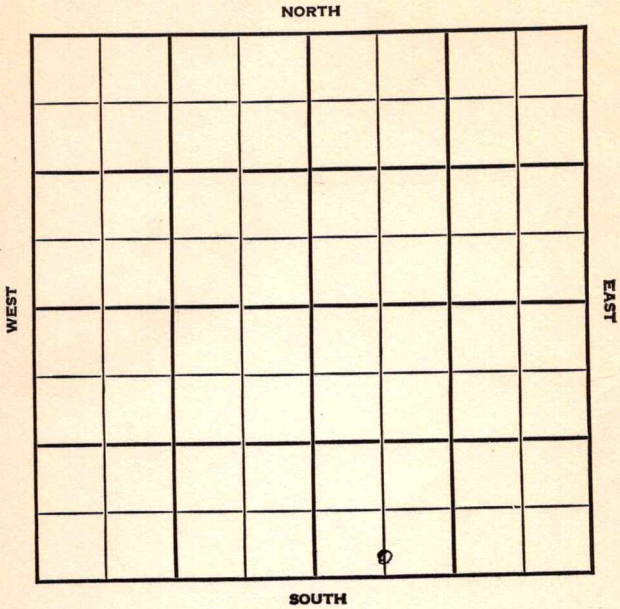


Section 6 Township 26 Range 5E

Well No. #21 Barnhill

Company Cities Service



KANSAS

Butler

Sec. 6 Twp. 26 R. 5-EWell No. #21 Barnhill Farm _____

Cities Service

Company _____

Miscellaneous

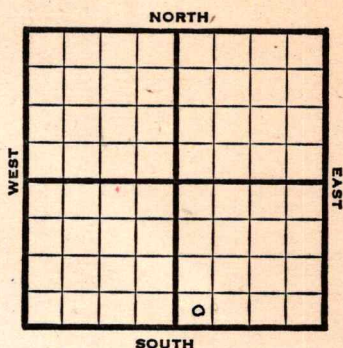
_____ Ft. from N. Line

330' Ft. from S. Line

_____ Ft. from E. Line

500' Ft. from W. Line

C S L SW S E

1947 **Elev. 1393'** REPORT

11/25 Spud

12/3 **Arbuckle 2431'**

TD 2433'

5" @ 2431'

RUST

12/10 "

12/17 "

12/30 "

1948
1/7 TD 2458'

Swb. 8 bbls. oil 2 hrs.

1/14 "

1/21 **Arb. 2431'**

5" @ 2431'

Rump 35 Pot

38.0 Gr.

TD 2458'

Comp.

COMPLETED

Map No. _____ Sec. 6 Twp. 26 R. 5E

Well No. 21 Barnhill

Cities Service Company

FIRST REPORT Contractor

C S L SW SE

SECTION PLAT

_____ Ft. from N. Line

330 Ft. from S. Line

_____ Ft. from E. Line

500 Ft. from W. Line

		o	

Butler County

Location _____

Rig up _____

Drilling and Remarks:

Spud

RECORD

Cased _____ in., _____ ft.

Sand _____

Gas _____

Oil _____

Total Depth _____

PRODUCTION

1st 24 hrs. Nat. _____

1st 24 hrs. after shot _____

Gas _____ Cu. Ft.

Dry Hole _____

Abandoned _____

Date

NOV 25 1947 19

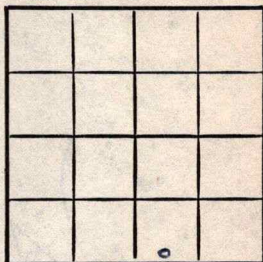
S. J. LEWIS Scout

Map No. 14 Sec. 6 Twp. 26 R. 5EWell No. 21 BarnhillCities Service Company

COMPLETE

Contractor

C S L SW SE

E11393
SECTION PLAT Ft. from N. Line330 Ft. from S. Line Ft. from E. Line500 Ft. from W. LineButler CountyLocation Rig up

Drilling and Remarks:

See 824315' 102431Pump 35 Bbl08-2-41

RECORD

Cased in., ft.Sand Gas Oil ✓Total Depth 2455

PRODUCTION

1st 24 hrs. Nat. 1st 24 hrs. after shot Gas Cu. Ft.Dry Hole Abandoned

Date

JAN 21 194819S. J. LEWISScout