

KANSAS


Section 6 Township 26 Range 5EWell No. #22 BarnhillCompany Cities Service

Miscellaneous

NORTH

WEST

EAST

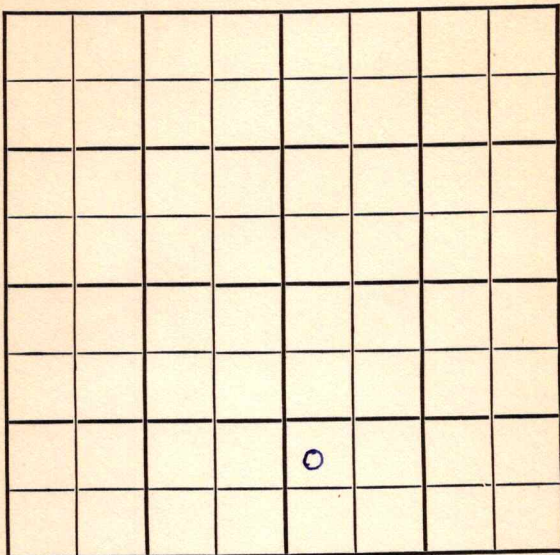

SOUTH

KANSAS

Butler

Sec. 6 Twp. 26 R. 5E ✓Well No. #22 Barnhill Farm

Cities Service Company

Miscellaneous


Ft. from N. Line

990' Ft. from S. Line

Ft. from E. Line

260' Ft. from W. Line

NW SW SE

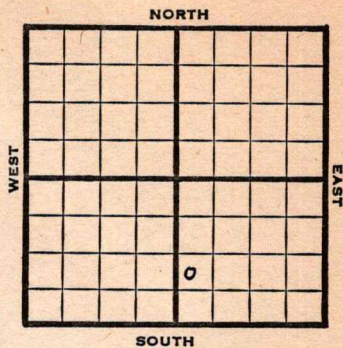

1948 Elev. - REPORT

2/18 Location

2/25 10" @ 83'

Lansing 1710'

KC 1992'

Arbuckle 2447'

TD 2450'

7" @ 2447'

RUST

3/3 TD 2480'

3/10 40 qts 2464'-80'
CO

3/17 "

3/24 Arb. 2447'

7" @ 2447'

Pump 24 oil & 9 W Pot.

Gr. 38

TD 2480'

COMPLETED

Map No. _____ Sec. 6 Twp. 26 R. 5E

Well No. 22 Barnhill

Cities Service Company

FIRST REPORT Contractor

NW SW SE

SECTION PLAT

		0	

_____ Ft. from N. Line

990 Ft. from S. Line

_____ Ft. from E. Line

260 Ft. from W. Line

Butler County

Location X

Rig up _____

Drilling and Remarks:

RECORD

Cased _____ in., _____ ft.

Sand _____

Gas _____

Oil _____

Total Depth _____

PRODUCTION

1st 24 hrs. Nat. _____

1st 24 hrs. after shot _____

Gas _____ Cu. Ft.

Dry Hole _____

Abandoned _____

Date

FEB 18 1948 19 S. J. LEWIS Scout

Map No. 14 Sec. 6 Twp. 26 R. 5E

Well No. 22 Barnhill

Cities Service Company

COMPLETE

Contractor

NW SW SE

SECTION PLAT

		o	

 Ft. from N. Line

990 Ft. from S. Line

 Ft. from E. Line

260 Ft. from W. Line

Butler County

Location

Rig up

Drilling and Remarks:

CV 2447

7' @ 2447

Run 24 in +

9W Pdx

28° E

RECORD

Cased in., ft.

Sand

Gas

Oil

Total Depth 2480

PRODUCTION

1st 24 hrs. Nat.

1st 24 hrs. after shot

Gas Cu. Ft.

Dry Hole

Abandoned

Date

MAR 24 1948

19

S. J. LEWIS

Scout