KANSAS
FORM 51 5M 4-41 PETROL


Butler

Section 17 Township 26 Range 5-E

Well No. 18 Empire

Company Cities Service Oil

Eldorado Pool

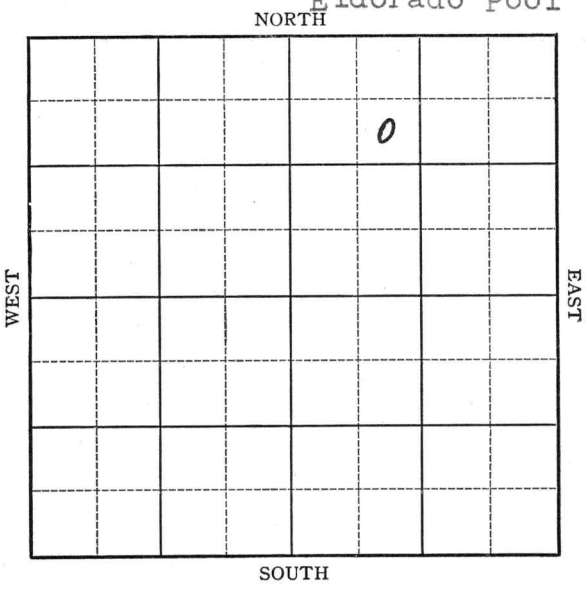

FORM 252-A 5M 1-41 PETROL KANSAS Butler

Sec. 17 Twp. 26 R. 5-E

Well No. #18 Empire Farm

Cities Service Oil Company


(Eldorado)

990 Ft. from N. Line

Ft. from S. Line

1650 Ft. from E. Line

Ft. from W. Line

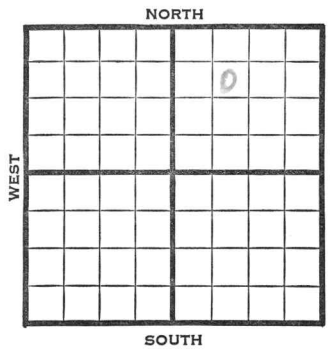

1941	REPORT
5/27	Lans. 1652'
	7" - 1656' T.D. 1661' RUST.
6/5	" " " " "
6/12	T.D. 1694' S.D.
6/19	" " "
6/26	T.D. 1694' SD.
7/3	" " "
7/10	" " "
7/17	" " "
7/24	" " "
7/31	" " "
8/7	" " "
8/13	Lans. 1652 7" - 1656'
	2000 acid
	T.D. 1694
	Pump. pot. 11 oil - 48 water
	36 Grav.
	COMPLETED

Form 26—200 Bks.—1-40—Palace Butler KANSAS

Map No. 14 Sec. 17 Twp. 26 R. 5E

Well No. 18 Empire

Cities Service Oil Company

Contractor

FIRST REPORT

SE NW NE

990 Ft. from N. Line


Ft. from S. Line

1650 Ft. from E. Line

Ft. from W. Line

ELDORADO POOL

SECTION PLAT

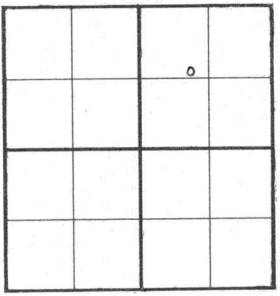

Location

Rig up

Drilling and Remarks:

Lansing 1652
T.D. 1661
7" - 1656 RUST

RECORD

Cased in., ft.

Sand

Gas

Oil

Total Depth

PRODUCTION

1st 24 hrs. Nat.

1st 24 hrs. after shot

Gas Cu. Ft.

Dry Hole

Abandoned

Date

MAY 27 1941 19

S. J. LEWIS Scout

Form 26 200 Bks. 5-41 McW. KANSAS Butler

Map No. 14 Sec. 17 Twp. 26 R. 5E

Well No. 18 Empire

Cities Service Oil Company

Contractor

COMPLETED

SE NW NE

990 Ft. from N. Line


Ft. from S. Line

1650 Ft. from E. Line

Ft. from W. Line

ELDORADO POOL

SECTION PLAT

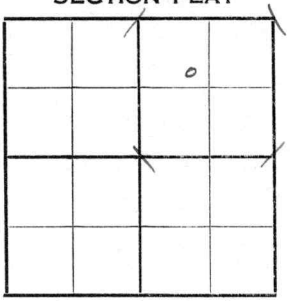

Location

Rig up

Drilling and Remarks:

Lans 1652'
7" 1656
2000 acid
Pmp Bbl. 1 oil.
48 wat.

RECORD

Cased in., ft.

Sand

Gas

Oil

Total Depth 1694

PRODUCTION

1st 24 hrs. Nat.

1st 24 hrs. after shot

Gas Cu. Ft.

Dry Hole

Abandoned

C 36 grav

Date

8/13/41 19 S. J. LEWIS Scout