


Greenwood

KANSAS

SECTION 34 TOWNSHIP 26S RANGE 12E

WELL NO. #1 Marlin

COMPANY TEC Drlg. Co.

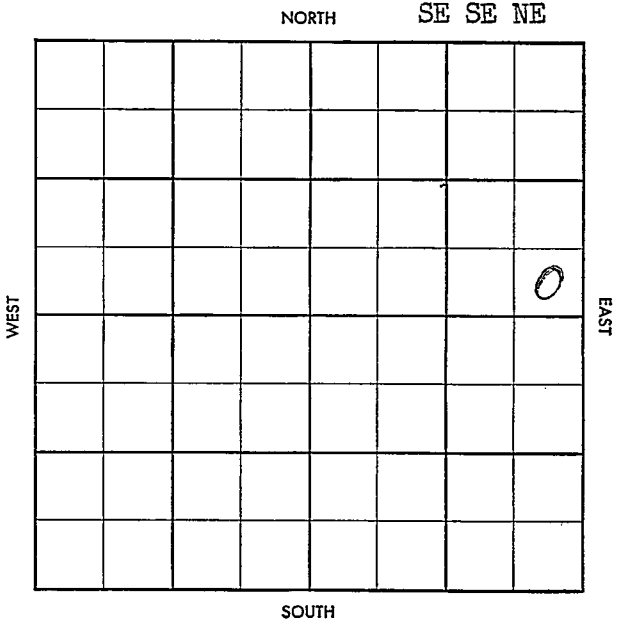

~~34~~ WILDCAT

S-513-A

CO. Greenwood ELEV. _____

SEC. 34 TWP. 26 RGE. 12E

COMPANY TEC Drlg. Co. NO. 1

FIRST RECORDED	
NOV 6	57

FARM Marlin Texas Co. - (AG) & (DHM)
Phillips (DHM)

LOC. SE SE NE

GEOL. _____

CONTR. Co. Tools

POOL Wildcat

SPUD 10/31/57 Drlg. 525

CO.

USE

NO.

SEC.

TWP.

RGE.

S-513-A

CO. Greenwood ELEV 1195/23
 SEC. 34 TWP. 26 RGE. 12E
 COMPANY TEC Drilling Co. NO. 1

ABANDONED

DEC 4 '57

FARM Marlin Texas Co. - (AC) & (BIR)
 LOC. SE-S4-ND Phillips (BIR)

GEOL. X
 CONTR. Co. 1-25
 POOL Wildcat
 SPUD 10/2/57
Ø 1150

M 1847 Ø 1937
~~125-125-5~~
 Log TOPS
 M 1840 B Miss

2120 A 2174 TD 2220

D6A

CO.
 LSE
 NO.
 SEC.
 TWP.
 RGE.