


Map No. _____ Sec. 17 Twp. 26 R. 5
Well No. 43 Hoogler Farm
Empire Company

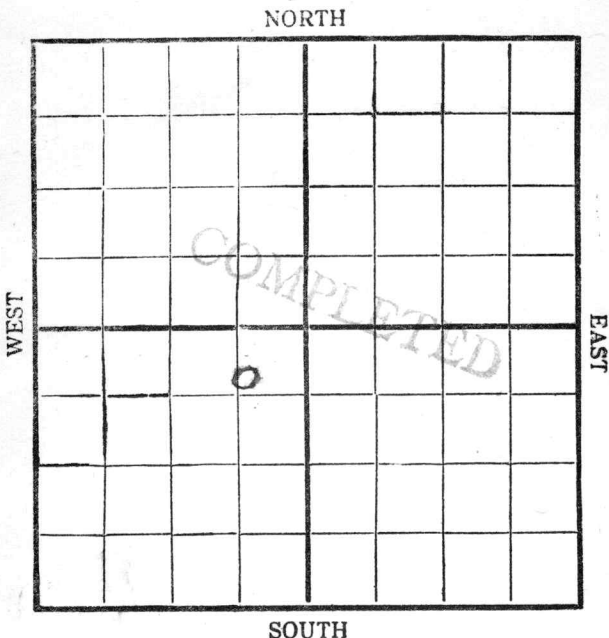

Location _____

Rig Up _____

Drilling Remarks:

Drilling Remarks:

8-23-19

Sand 2376'

2440'

50 bbls in 8 hours

RECORD

PRODUCTION

Cased _____ in. _____ ft.

1st 24 hrs. Nat. _____

Sand _____

1st 24 hrs. after shot _____

Gas _____

Gas _____ cu. ft.


Oil _____

Dry Hole _____

Total Depth _____

Abandoned _____

Map No. K14 Sec. 17 Twp. 26 R. 5
Well No. 43 Koogler
Empire Company
Contractor

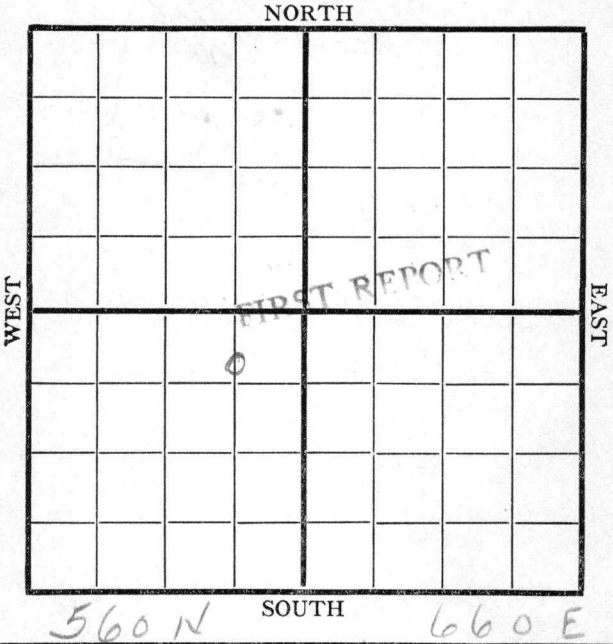

Location _____ Rig up _____ Drilling and Remarks: <u>355'</u>	RECORD Cased _____ in., _____ ft. Sand _____ Gas _____ Oil _____ Total Depth _____
	PRODUCTION 1st 24 hrs. Nat. _____ 1st 24 hrs. after shot _____ Gas _____ Cu. Ft. Dry Hole _____ Abandoned _____

Date 4/27 1919 **Pyle** Scout


Map No. 1514 Sec. 17 Twp. 26 R. 5Well No. 43 RooglerCompany Empire

Contractor _____

NORTH

WEST

EAST

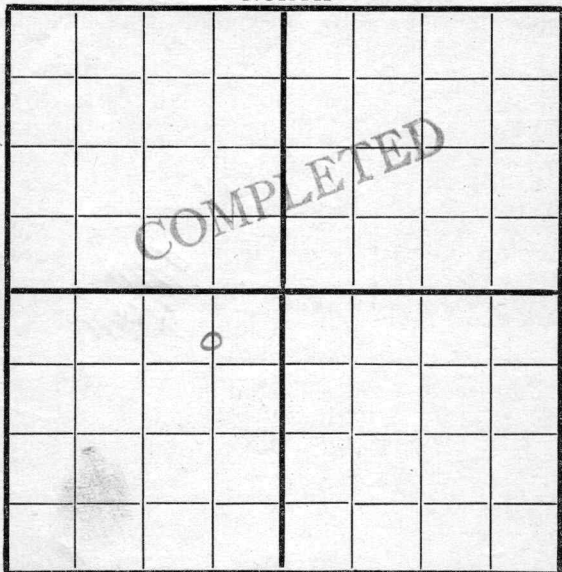

SOUTH

660 E560 N

Location _____

Rig up _____

Drilling and Remarks:

50 bbls
in 8 hours

RECORD

Cased _____ in., _____ ft.

Sand 2376-2440

Gas _____

Oil _____

Total Depth _____

PRODUCTION

1st 24 hrs. Nat. _____

1st 24 hrs. after shot _____

Gas _____ Cu. Ft.

Dry Hole _____

Abandoned _____

Date

8/19 1919Dyke Scout