


Greenwood

DX 78-1

KANSAS

Section 11 Township 23 Range 9EWell No. #1 Bilson-GreenCompany Miller-Snyder

NORTH

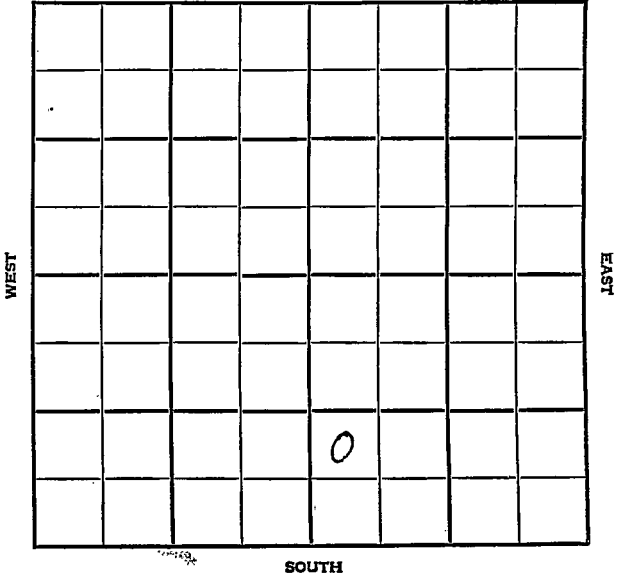

SOUTH

Greenwood

KANSAS

SEC.	TWP.	R.
11	23	9E

WELL NO.

#1 Bilson-Green

FARM

COMPANY

Miller-Snyder.

CONTRACTOR

Ola Berentz


Teeter Pool NORTH

Ft. from N. Line

960 Ft. from S. Line

Ft. from E. Line

150 Ft. from W. Line

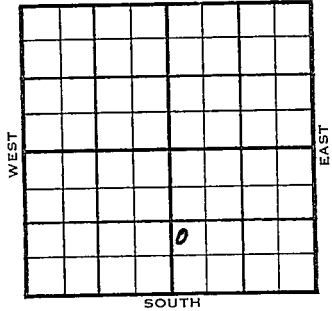

NW SW SE

	ELEVATION	REPORT
1955	---	

4/13

Spud 4-10-55

8" @ 80'

Drlg. 11/12'

~~7/13 XXXXXX Abandoned Location~~

County Greenwood State KansasSec. 11 (Blk.) 23 (Sur.) 9E Map No.Operator Miller-SnyderWell No. 1 Farm Bilson-GreenElev. Location NW SW SE

FIRST REPORT

960 Ft. From S Line SE150 Ft. From W Line Quarter1st. Report APR 13 1955

Completion

Remarks

Ola Berentz - Contr.Spudding Date 4-10-55Drlg. Data Teeter Pool8" @ 80 drlg. 1442

FABEN GILSTRAP