
Form 51 5M 8-24 14567

Map No. Kansas Sec. 11 Twp. 23 R. 9 X

Well No. 1 Green Farm

Mc Ginnis Butler Company

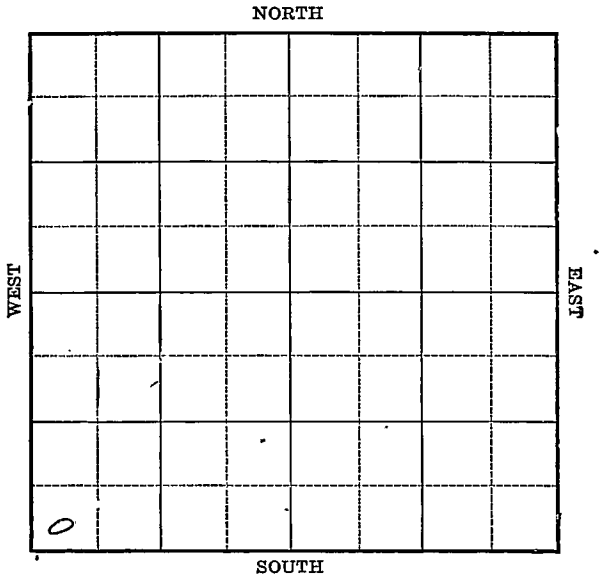

Location

Drilling Remarks

Rig Up

Drilling Remarks

RECORD

Cased in. ft.

Sand

Gas

Oil

Total Depth

PRODUCTION

1st 24 hrs. Nat.

1st. 24 hrs. after shot

Gas cu. ft.

Dry Hole


Abandoned

Form 252A 5M 8-24 16529

Map No. Kansas Sec. 11 Twp. 23 R. 9

Well No. 1 Green Farm

McGinnis Butler Company

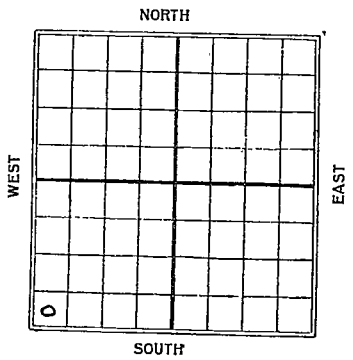

_____ Ft. from N. Line

330 Ft. from S. Line

_____ Ft. from E. Line

330 Ft. from W. Line

Date 1925	REPORT
3/1	Location
4/10	Abandoned Location

Form 26—1M Bks.—3-23—11959.

12

Map No. KANSAS Sec. 11 Twp. 23 R. 9


Well No. 1 Green

McGinnis Bitter Company

Contractor

FIRST REPORT

SECTION PLAT

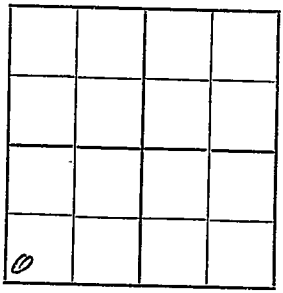

_____Ft. from N. Line

330 Ft. from S. Line

_____Ft. from E. Line

330 Ft. from W. Line

Location _____

Rig up _____

Drilling and Remarks:

RECORD

Cased _____ in., _____ ft.

Sand _____

Gas _____

Oil _____

Total Depth _____

PRODUCTION

1st 24 hrs. Nat. _____

1st 24 hrs. after shot _____

Gas _____ Cu. Ft.

Dry Hole _____

Abandoned _____

Date

3/1 1925

M. A. BENEAR

Scout

Form 26—1M Bks.—3-23—11959.

Map No. Kindle Sec. 11 Twp. 23 R. 9 E

Well No. 1 Moser

Mc Dinnis & Al Company

Contractor

COMPLETED

Ft. from N. Line


330 Ft. from S. Line

Ft. from E. Line

330 Ft. from W. Line

ABANDONED

SECTION PLAT

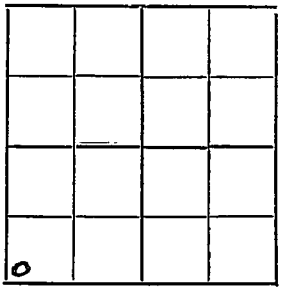

Location

Rig up

Drilling and Remarks:

No hole made

RECORD

Cased in., ft.

Sand

Gas

Oil

Total Depth

PRODUCTION

1st 24 hrs. Nat.

1st 24 hrs. after shot

Gas Cu. Ft.

Dry Hole Location

Abandoned

Date

APR 10 1925

192

W. L. Howes Scout