


Map No. _____ Sec 6 Twp 26 R 5Well No. 12 Porter Farm _____
Carter Company _____

NORTH

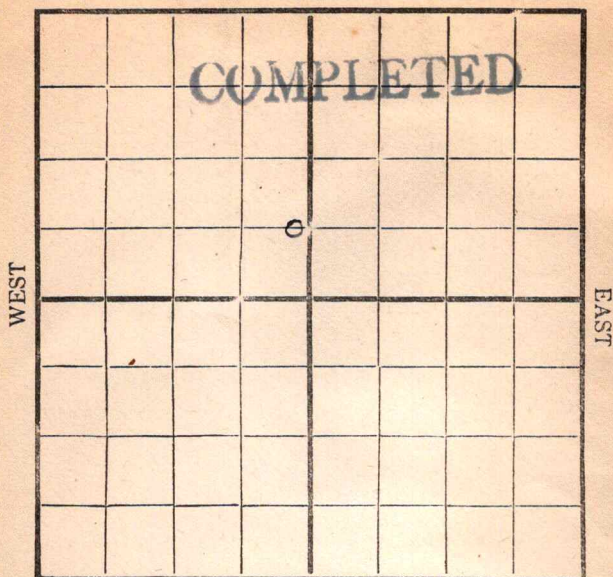

SOUTH

Location _____

Rig Up _____

Drilling Remarks:

Drilling Remarks:

RECORD

Cased _____ in _____ Ft.

Sand _____

Gas _____

Oil _____

Total Depth _____

PRODUCTION

1st 24 hrs. Nat. _____

1st 24 hrs. after shot _____

Gas _____ Cu. Ft.

Dry Hole _____


Abandoned _____

Map No. _____ Sec. 6 Twp. 26 R. 5
 Well No. 12 Porter Farm _____
Porter Company _____

NORTH

WEST

EAST

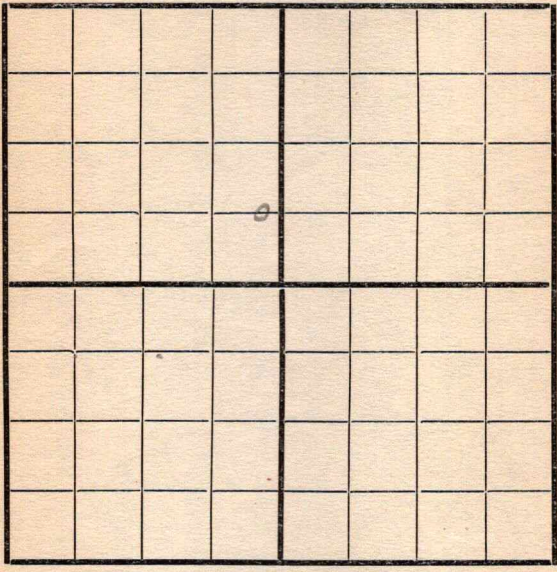

SOUTH

Location _____
 Rig Up _____
 Drilling and remarks _____

RECORD

Cased _____ in. _____ Ft.
 Sand _____
 Gas _____
 Oil _____
 Total Depth _____

FIRST REPORT

PRODUCTION

1st 24 hrs. Nat. _____
 1st 24 hrs. after shot _____
 Gas _____ Cu. Ft.
 Dry Hole _____
 Abandoned _____

Date 3/5, 1917 Carly Scout _____

Map No. _____ Sec. 6 Twp. 26 R. 5
 Well No. 12 Porter Farm _____
Carter Company

NORTH

SOUTH

WEST

EAST

Location _____
 Rig up _____
 Drilling and Remarks:

Rig up

RECORD

Cased _____ in. _____ Ft.
 Sand _____
 Gas _____
 Oil _____
 Total Depth _____

PRODUCTION

1st 24 hrs. Nat. _____
 1st 24 hrs. after shot _____
 Gas _____ Cu. Ft.
 Dry Hole _____
 Abandoned _____

Date 3/12, 1912, Carter Scout

Map No. _____ Sec. 6 Twp. 26 R. 5
 Well No. 62 Patten Farm _____
Center Company _____

NORTH

WEST

EAST

SOUTH

Location _____
 Rig Up _____
 Drilling and remarks _____

RECORD

Cased _____ in. _____ Ft.
 Sand _____
 Gas _____
 Oil _____
 Total Depth _____

PRODUCTION


1st 24 hrs. Nat. _____
 1st 24 hrs. after shot _____
 Gas _____ Cu. Ft.
 Dry Hole _____
 Abandoned _____

Date 3/21, 191 7 Carney Scout

Map No. _____ Sec. 6 Twp. 26 R. 5
 Well No. 12 Porter Farm _____
Canter Company _____

NORTH

WEST

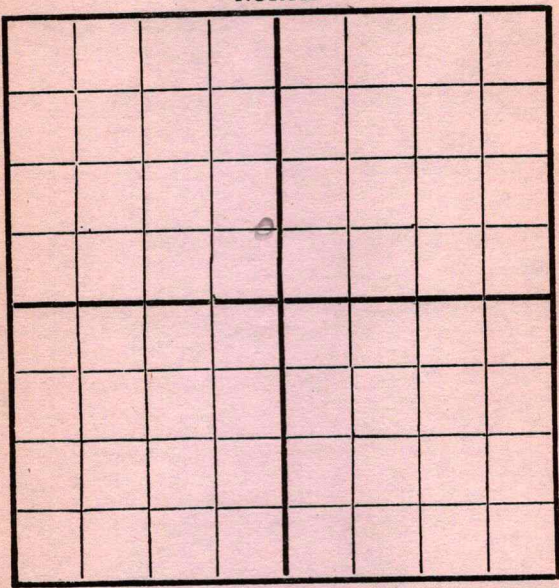

EAST

SOUTH

Location _____
 Rig Up _____
 Drilling and remarks _____

Rigging up

RECORD

Cased _____ in. _____ Ft.
 Sand _____
 Gas _____
 Oil _____
 Total Depth _____


PRODUCTION

1st 24 hrs. Nat. _____
 1st 24 hrs. after shot _____
 Gas _____ Cu. Ft.
 Dry Hole _____
 Abandoned _____

Date 3/26, 1912 Canter Scout _____

Map No. _____ Sec. 6 Twp. 26 R. 5
 Well No. 12 Patton Farm _____
Butter Company _____

NORTH

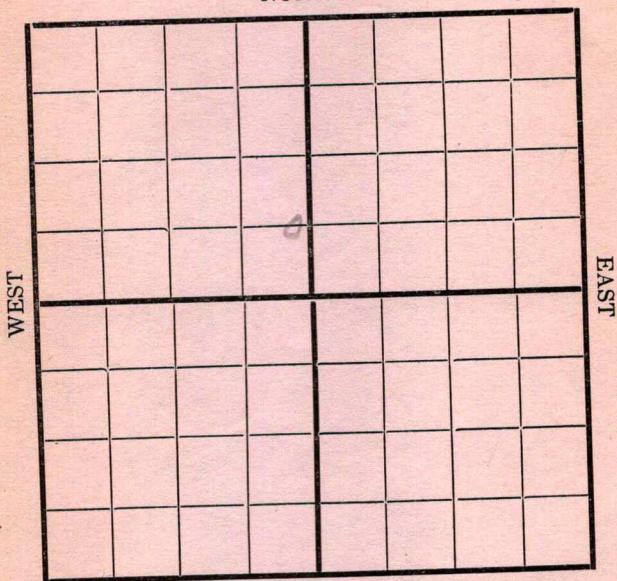

SOUTH

Location _____
 Rig Up _____
 Drilling and remarks _____

Spudding

RECORD

Cased _____ in. _____ Ft.
 Sand _____
 Gas _____
 Oil _____
 Total Depth _____

PRODUCTION


1st 24 hrs. Nat. _____
 1st 24 hrs. after shot _____
 Gas _____ Cu. Ft.
 Dry Hole _____
 Abandoned _____

Date

4/5, 191 7 *Carley* Scout

Map No. _____ Sec. 6 Twp. 26 R. 5
 Well No. 12 Porter Farm _____
Porter Company _____

NORTH

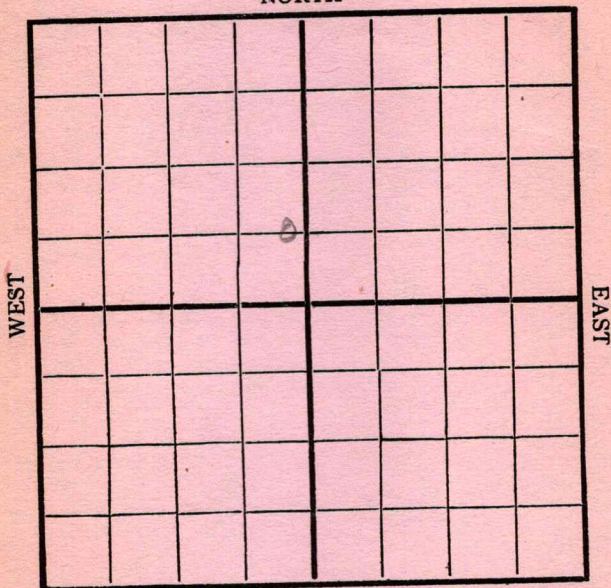

SOUTH

Location _____
 Rig Up _____
 Drilling and remarks

590

RECORD

Cased _____ in. _____ Ft.
 Sand _____
 Gas _____
 Oil _____
 Total Depth _____

PRODUCTION


1st 24 hrs. Nat. _____
 1st 24 hrs. after shot _____
 Gas _____ Cu. Ft.
 Dry Hole _____
 Abandoned _____

Date

4/11, 1917 Carlsberg Scout

Map No. _____ Sec. 6 Twp. 26 R. 5
 Well No. 12 Porter Farm _____
Porter Company _____

NORTH

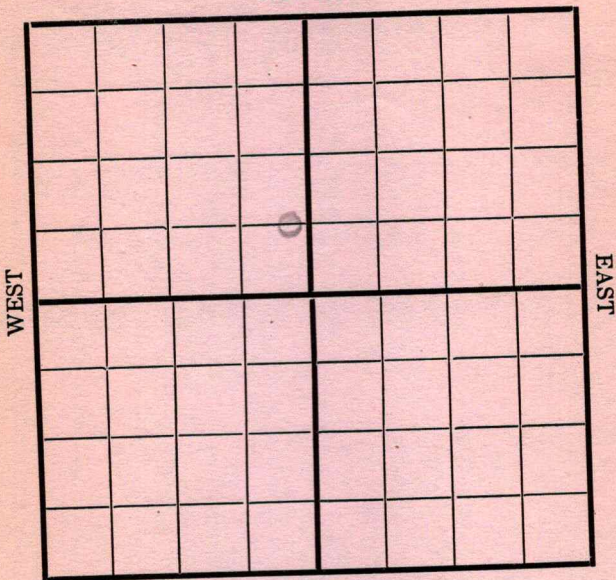

SOUTH

Location _____
 Rig Up _____
 Drilling and remarks _____

945

RECORD

Cased _____ in. _____ Ft.
 Sand _____
 Gas _____
 Oil _____
 Total Depth _____

PRODUCTION


1st 24 hrs. Nat. _____
 1st 24 hrs. after shot _____
 Gas _____ Cu. Ft.
 Dry Hole _____
 Abandoned _____

Date

4/19 191 2 Porter Scout

Map No. _____ Sec. 6 Twp. 26 R. 5
Well No. 12 Porta _____ Farm
Center _____ Company

NORTH

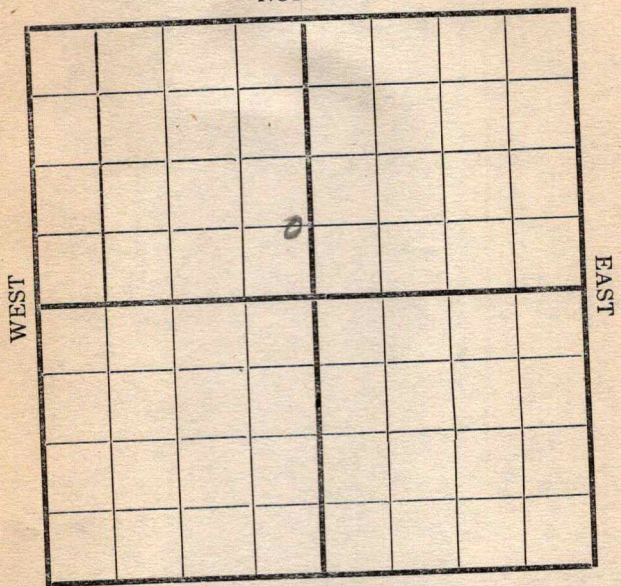


SOUTH

Location _____ Rig Up _____ Drilling and remarks _____	RECORD
	Cased _____ in. _____ Ft.
	Sand _____
	Gas _____
	Oil _____
	Total Depth _____
	PRODUCTION
	1st 24 hrs. Nat. _____
	1st 24 hrs. after shot _____
	Gas _____ Cu. Ft.
	Dry Hole _____
	Abandoned _____

Date APR 26 1917, 191_____
Parley Scout

Map No. _____ Sec. 6 Twp 26 R. 5
 Well No. 12 Porter Farm _____
Carter Company

NORTH

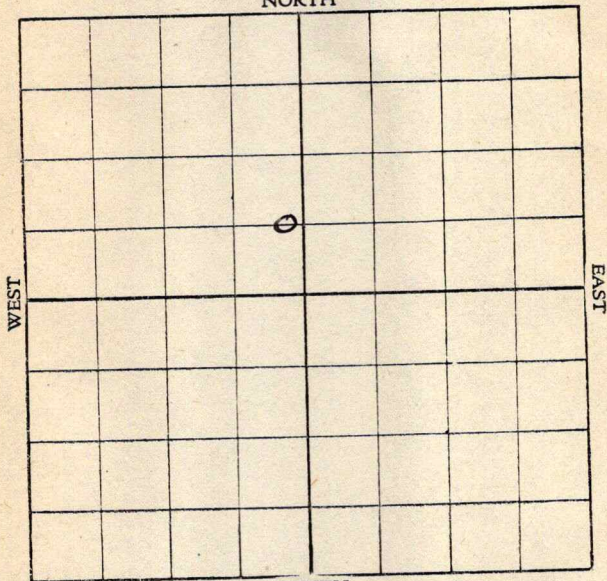

SOUTH

Location _____

Rig up _____

Drilling and remarks:

D-1460'

RECORD

Cased _____ in. _____ Ft.

Sand _____

Gas _____

Oil _____

Total Depth _____

PRODUCTION

1st 24 hrs. Nat. _____

1st 24 hrs. after shot _____

Gas _____ Cu. Ft.

Dry Hole _____

Abandoned _____

Date

5/5


, 191

7Porter

Scout

Map No. _____ Sec. 6 Twp. 26 R. 5Well No. 12 Porter Farm _____Carter Company _____

NORTH

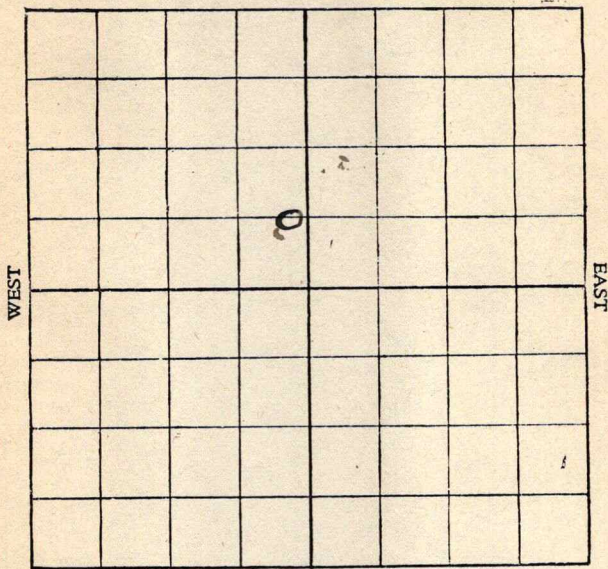

SOUTH

Location _____

Rig up _____

Drilling and remarks:

D.-1725'

RECORD

Cased _____ in. _____ Ft.

Sand _____

Gas _____

Oil _____

Total Depth _____

PRODUCTION

1st 24 hrs. Nat. _____

1st 24 hrs. after shot _____

Gas _____ Cu. Ft.


Dry Hole _____

Abandoned _____

Date

5/12, 1917, Crocker Scout

Map No. _____ Sec. 6 Twp. 26 R. 5
 Well No. 12 Porter Farm _____
Carter Company _____
 NORTH

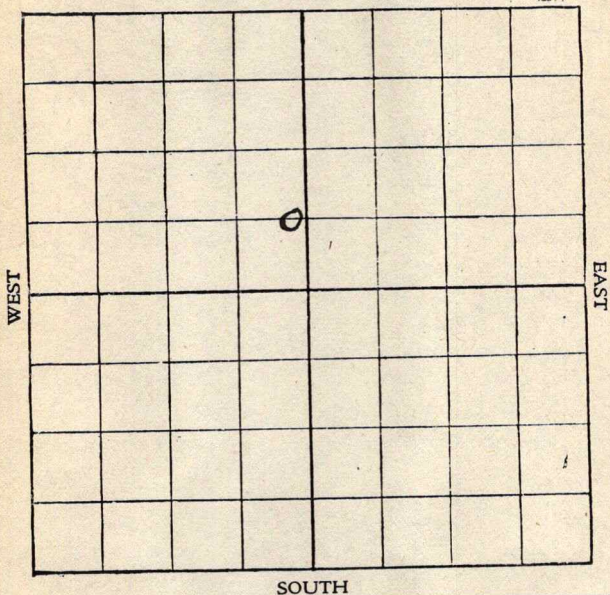

Location _____

Rig up _____

Drilling and remarks:

D-1940'

RECORD

Cased _____ in. _____ Ft.

Sand _____

Gas _____

Oil _____

Total Depth _____

PRODUCTION

1st 24 hrs. Nat. _____

1st 24 hrs. after shot _____

Gas _____ Cu. Ft.

Dry Hole _____


Abandoned _____

Date

5/19, 1917, Crocker Scout

Map No. _____ Sec. 6 Twp. 24 R. 5Well No. 12 Porter Farm __________Carter Company

NORTH

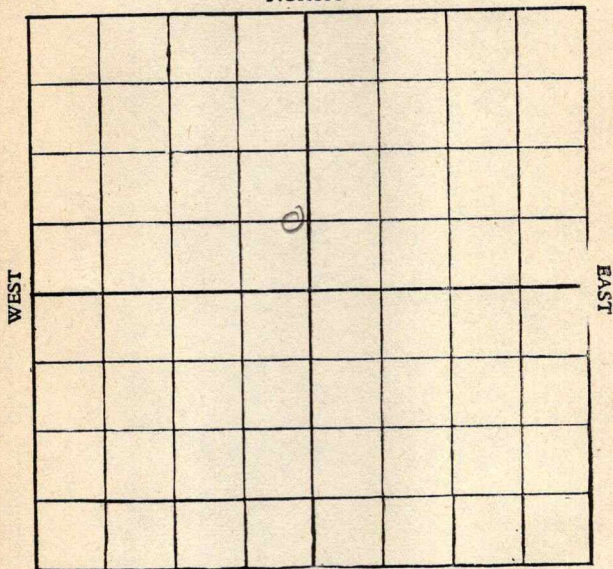

SOUTH

Location _____

Rig up _____

Drilling and remarks:

D-2125'

RECORD

Cased _____ in. _____ Ft.

Sand _____

Gas _____

Oil _____

Total Depth _____

PRODUCTION

1st 24 hrs. Nat. _____

1st 24 hrs. after shot _____

Gas _____ Cu. Ft.

Dry Hole _____


Abandoned _____

Date

5/26, 1917, Proctor Scout

Map No. _____ Sec. 6 Twp. 24 R. 5
 Well No. 12 Porter Farm _____
Carter Company _____

NORTH

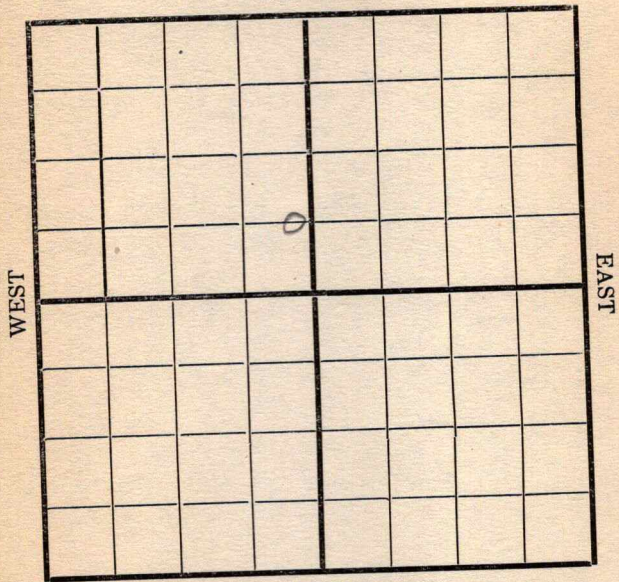

SOUTH

Location _____
 Rig Up _____
 Drilling and remarks _____

D-2310

RECORD

Cased _____ in. _____ Ft.
 Sand _____
 Gas _____
 Oil _____
 Total Depth _____

PRODUCTION

1st 24 hrs. Nat. _____
 1st 24 hrs. after shot _____
 Gas _____ Cu. Ft.
 Dry Hole _____
 Abandoned _____


Date

6/27 1917 Crocker Scout

Map No. _____ Sec. 6 Twp. 26 R. 5

Well No. 12 Porter Farm _____

Carter Company _____

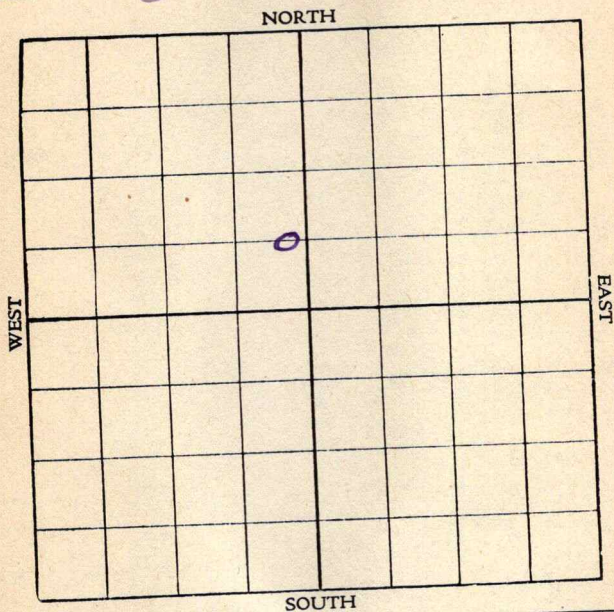

Location _____

Rig up _____

Drilling and remarks:

TS. 2494

RECORD

Cased _____ in. _____ Ft.

Sand _____

Gas _____

Oil _____

Total Depth _____

PRODUCTION

1st 24 hrs. Nat. _____

1st 24 hrs. after shot _____

Gas _____ Cu. Ft.

Dry Hole _____

Abandoned _____

Date _____

G. J. Crocker


JUN 9 - 1917

, 191 _____,

Scout

Map No. _____ Sec. 6 Twp. 26 R. 5
 Well No. 12 Porter Farm _____
Carter Company _____

NORTH

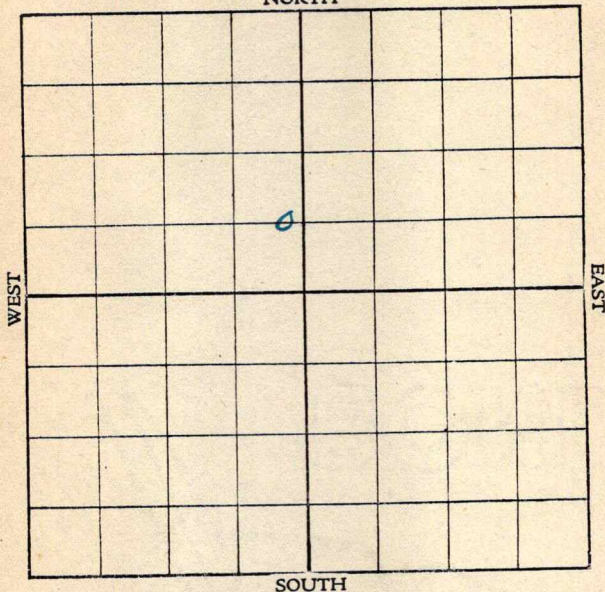

SOUTH

Location _____

Rig up _____

Drilling and remarks:

T.S. 2494

Cleaning out.

RECORD

Cased _____ in. _____ Ft.

Sand _____

Gas _____

Oil _____

Total Depth _____

PRODUCTION

1st 24 hrs. Nat. _____

1st 24 hrs. after shot _____

Gas _____ Cu. Ft.

Dry Hole _____


Abandoned _____

Date

JUN 16 1971

C. J. Crocker Scout

Map No. _____ Sec. 6 Twp. 26 R. 5
 Well No. 12 Porter Farm _____
Carter Company _____

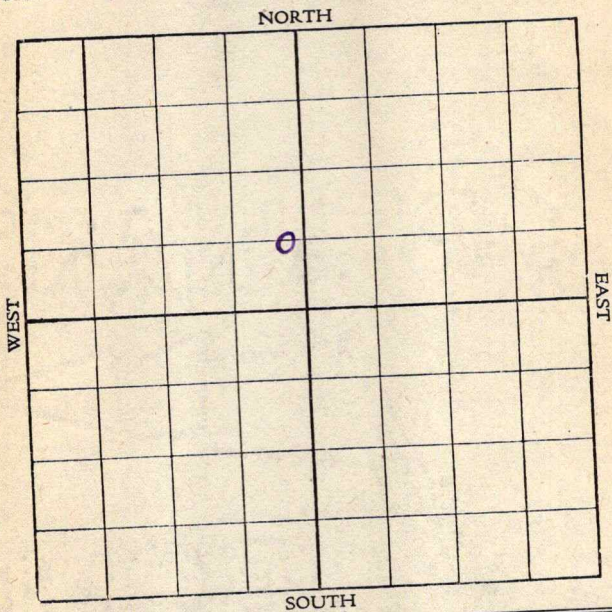

Location _____
 Rig up _____
 Drilling and remarks: _____

RECORD

Cased _____ in. _____ Ft.
 Sand _____
 Gas _____
 Oil _____
 Total Depth _____

PRODUCTION

1st 24 hrs. Nat. _____
 1st 24 hrs. after shot _____
 Gas _____ Cu. Ft.
 Dry Hole _____
 Abandoned _____


Date

JUN 22 1917

, 191

E. J. Crocker Scout.

Map No. _____ Sec. 6 Twp. 26 R. 5
 Well No. 12 Porter Farm _____
Carter Company _____

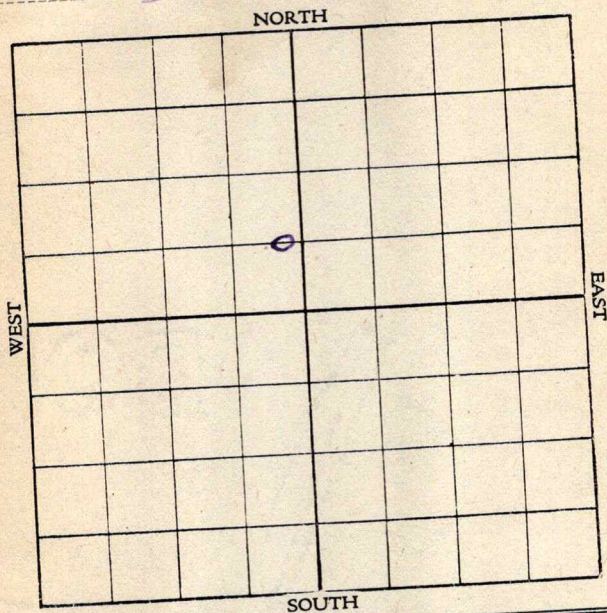

Location _____

Rig up _____

Drilling and remarks:

I.S. 2494
Cleaning
out.

RECORD

Cased _____ in. _____ Ft.

Sand _____

Gas _____

Oil _____

Total Depth _____

PRODUCTION

1st 24 hrs. Nat. _____

1st 24 hrs. after shot _____

Gas _____ Cu. Ft.

Dry Hole _____

Abandoned _____

Date JUN 30 1917

, 191


C. T. Crocker Scout

Map No. _____ Sec. 6 Twp. 26 R. 5

Well No. 12 Porter Farm

Carter Company

NORTH

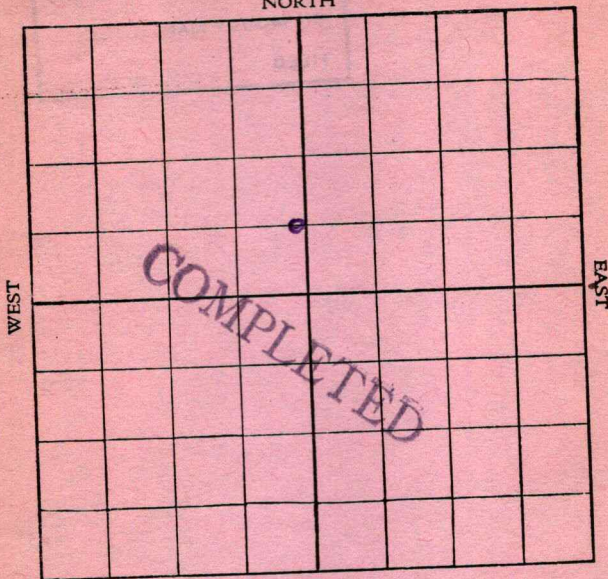

SOUTH

Location _____

Rig up _____

Drilling and remarks:

RECORD

Cased _____ in. _____ Ft.

Sand 2470-2494

Gas _____

Oil 250 bbls.

Total Depth 2494

PRODUCTION

1st 24 hrs. Nat. _____

1st 24 hrs. after shot _____

Gas _____ Cu. Ft.

Dry Hole _____

Abandoned _____

Date JUL 7 1917

_____, 191_____, C. T. Crocker Scout

2-35 Sec. 6, Twp 26 S, Range 5 E.

