


Map No. \_\_\_\_\_ Sec 6 Twp 26 R 5  
 Well No. 17 Porter Farm \_\_\_\_\_  
Chater Company \_\_\_\_\_

NORTH

WEST

EAST

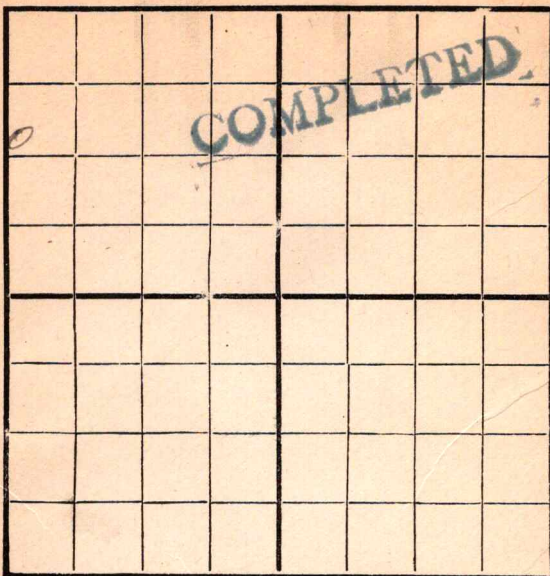

SOUTH

Location \_\_\_\_\_

Rig Up \_\_\_\_\_

Drilling Remarks:

Drilling Remarks:

\_\_\_\_\_  
 \_\_\_\_\_  
RECORD

PRODUCTION

Cased \_\_\_\_\_ in \_\_\_\_\_ Ft.

Sand \_\_\_\_\_

Gas \_\_\_\_\_

Oil \_\_\_\_\_

Total Depth \_\_\_\_\_

1st 24 hrs. Nat. \_\_\_\_\_

1st 24 hrs. after shot \_\_\_\_\_


Gas \_\_\_\_\_ Cu. Ft.

Dry Hole \_\_\_\_\_

Abandoned \_\_\_\_\_

Map No. \_\_\_\_\_ Sec. 6 Twp. 26 R. 5Well No. 17 Porter Farm \_\_\_\_\_  
Barter Oil Company

NORTH

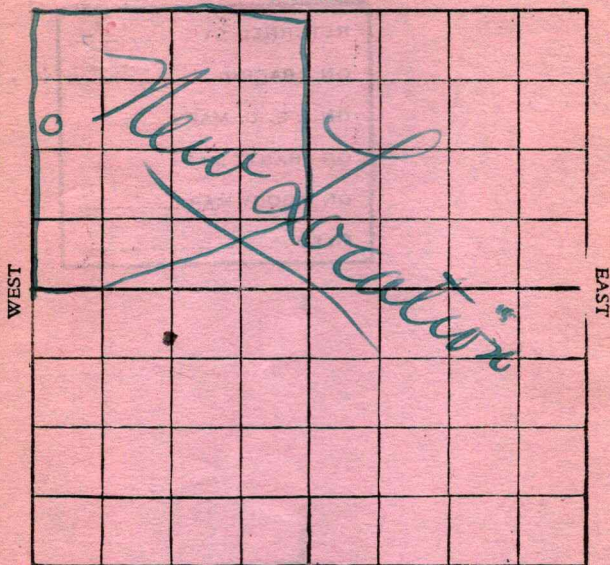

SOUTH

Location \_\_\_\_\_

Rig up \_\_\_\_\_

Drilling and remarks:

Rig.

## RECORD

Cased \_\_\_\_\_ in. \_\_\_\_\_ Ft.

Sand \_\_\_\_\_

Gas \_\_\_\_\_

Oil \_\_\_\_\_

Total Depth \_\_\_\_\_

## PRODUCTION

1st 24 hrs. Nat. \_\_\_\_\_

1st 24 hrs. after shot \_\_\_\_\_

Gas \_\_\_\_\_ Cu. Ft.

Dry Hole \_\_\_\_\_

Abandoned \_\_\_\_\_

Date

5/26, 1917, Crocker Scout




Map No. \_\_\_\_\_ Sec. 6 Twp. 26 R. 5  
Well No. 17 Porter Farm  
Carter Company

NORTH

WEST

EAST

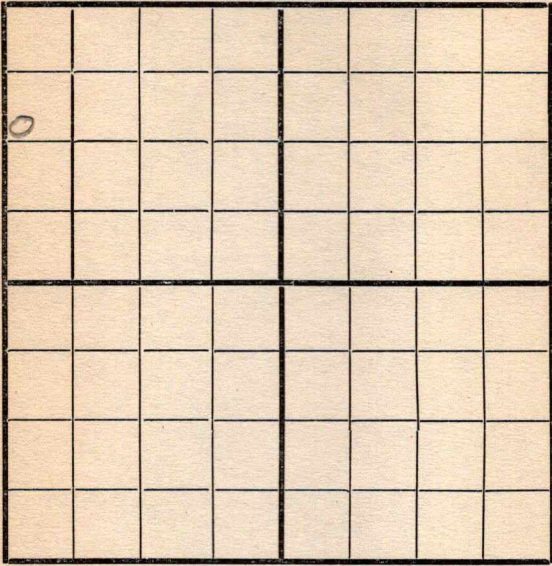

SOUTH

Location \_\_\_\_\_  
Rig Up \_\_\_\_\_  
Drilling and remarks  
Rig

RECORD

Cased \_\_\_\_\_ in. \_\_\_\_\_ Ft.  
Sand \_\_\_\_\_  
Gas \_\_\_\_\_  
Oil \_\_\_\_\_  
Total Depth \_\_\_\_\_

PRODUCTION

1st 24 hrs. Nat. \_\_\_\_\_  
1st 24 hrs. after shot \_\_\_\_\_  
Gas \_\_\_\_\_ Cu. Ft.  
Dry Hole \_\_\_\_\_  
Abandoned \_\_\_\_\_

Date 6/27 1917 Crocker Scout

Map No. \_\_\_\_\_ Sec. 6 Twp. 26 R. 5Well No. 17 - Porter Farm \_\_\_\_\_  
Carter Company \_\_\_\_\_

NORTH

|          |  |  |  |  |  |  |  |
|----------|--|--|--|--|--|--|--|
|          |  |  |  |  |  |  |  |
| <u>0</u> |  |  |  |  |  |  |  |
|          |  |  |  |  |  |  |  |
|          |  |  |  |  |  |  |  |
SOUTH

Location \_\_\_\_\_

Rig up \_\_\_\_\_

Drilling and remarks:

Rig.

## RECORD

Cased \_\_\_\_\_ in. \_\_\_\_\_ Ft.

Sand \_\_\_\_\_

Gas \_\_\_\_\_

Oil \_\_\_\_\_

Total Depth \_\_\_\_\_

## PRODUCTION

1st 24 hrs. Nat. \_\_\_\_\_

1st 24 hrs. after shot \_\_\_\_\_

Gas \_\_\_\_\_ Cu. Ft.

Dry Hole \_\_\_\_\_

Abandoned \_\_\_\_\_

Date

JUN 9 1917

C. J. Crocker Scout



Map No. \_\_\_\_\_ Sec. 6 Twp. 26 R. 5Well No. 17 Porter Farm \_\_\_\_\_Carter Company \_\_\_\_\_

NORTH

|  |  |  |  |  |  |  |  |
|--|--|--|--|--|--|--|--|
|  |  |  |  |  |  |  |  |
|  |  |  |  |  |  |  |  |
WEST

EAST

SOUTH

Location \_\_\_\_\_

Rig up \_\_\_\_\_

Drilling and remarks:

Rig.

## RECORD

Cased \_\_\_\_\_ in. \_\_\_\_\_ Ft.

Sand \_\_\_\_\_

Gas \_\_\_\_\_

Oil \_\_\_\_\_

Total Depth \_\_\_\_\_

## PRODUCTION

1st 24 hrs. Nat. \_\_\_\_\_

1st 24 hrs. after shot \_\_\_\_\_

Gas \_\_\_\_\_ Cu. Ft.

Dry Hole \_\_\_\_\_

Abandoned \_\_\_\_\_


Date

JUN 16 1917

191

E. J. Crocker Scout

Map No. \_\_\_\_\_ Sec. 6 Twp. 26 R. 5  
Well No. 17 Porter Farm \_\_\_\_\_  
Carter Company \_\_\_\_\_

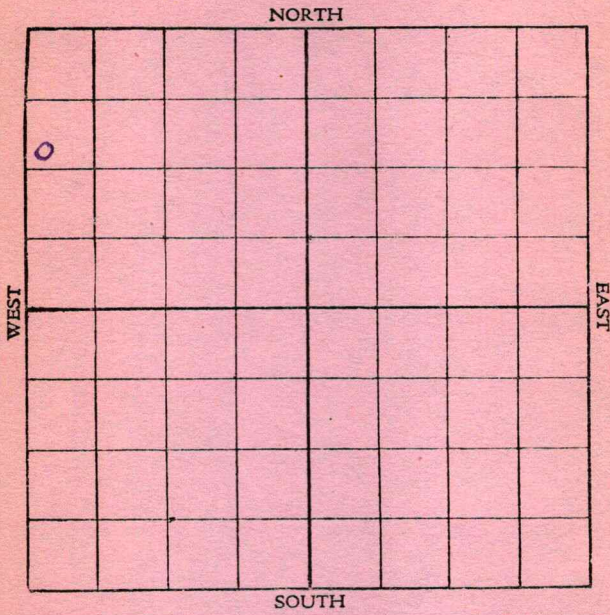

|                                                                            |   |
|----------------------------------------------------------------------------|---|
| Location _____<br>Rig up _____<br>Drilling and remarks:<br><br><u>Rig.</u> | <b>RECORD</b><br>Cased _____ in. _____ Ft.<br>Sand _____<br>Gas _____<br>Oil _____<br>Total Depth _____                               |
|                                                                            | <b>PRODUCTION</b><br>1st 24 hrs. Nat. _____<br>1st 24 hrs. after shot _____<br>Gas _____ Cu. Ft.<br>Dry Hole _____<br>Abandoned _____ |

Date \_\_\_\_\_  
JUN 22 1917, 1917, E. J. Porter Scout



Map No. \_\_\_\_\_ Sec. 6 Twp. 26 R. 5Well No. 17 Porter Farm \_\_\_\_\_Company Carter

NORTH

|          |  |  |  |  |  |  |  |
|----------|--|--|--|--|--|--|--|
|          |  |  |  |  |  |  |  |
| <u>0</u> |  |  |  |  |  |  |  |
|          |  |  |  |  |  |  |  |
|          |  |  |  |  |  |  |  |
SOUTH

Location \_\_\_\_\_

Rig up ✓

Drilling and remarks:

## RECORD

Cased \_\_\_\_\_ in. \_\_\_\_\_ Ft.

Sand \_\_\_\_\_

Gas \_\_\_\_\_

Oil \_\_\_\_\_

Total Depth \_\_\_\_\_

## PRODUCTION

1st 24 hrs. Nat. \_\_\_\_\_

1st 24 hrs. after shot \_\_\_\_\_

Gas \_\_\_\_\_ Cu. Ft.

Dry Hole \_\_\_\_\_

Abandoned \_\_\_\_\_

Date JUN 30 1917

, 191

C. J. Crocker  
Scott

Map No. \_\_\_\_\_ Sec. 6 Twp. 26 R. 5  
 Well No. 17 Porter Farm  
Carter Oil Company

NORTH

|   |  |  |  |  |  |  |  |
|---|--|--|--|--|--|--|--|
|   |  |  |  |  |  |  |  |
|   |  |  |  |  |  |  |  |
| 0 |  |  |  |  |  |  |  |
|   |  |  |  |  |  |  |  |
|   |  |  |  |  |  |  |  |
|   |  |  |  |  |  |  |  |
|   |  |  |  |  |  |  |  |
|   |  |  |  |  |  |  |  |

SOUTH

Location \_\_\_\_\_

Rig up ✓

Drilling and remarks:

RECORD

Cased \_\_\_\_\_ in. \_\_\_\_\_ Ft.

Sand \_\_\_\_\_

Gas \_\_\_\_\_

Oil \_\_\_\_\_

Total Depth \_\_\_\_\_

PRODUCTION

1st 24 hrs. Nat. \_\_\_\_\_

1st 24 hrs. after shot \_\_\_\_\_

Gas \_\_\_\_\_ Cu. Ft.

Dry Hole \_\_\_\_\_

Abandoned \_\_\_\_\_

Date JUL 7 1917

\_\_\_\_\_, 191\_\_\_\_, G. T. Crocker Scout



Map No. \_\_\_\_\_ Sec. 6 Twp. 26 R. 5  
 Well No. 17 Porter Farm \_\_\_\_\_  
Baxter Company \_\_\_\_\_

NORTH

|   |  |  |  |  |  |  |  |
|---|--|--|--|--|--|--|--|
|   |  |  |  |  |  |  |  |
|   |  |  |  |  |  |  |  |
| 0 |  |  |  |  |  |  |  |
|   |  |  |  |  |  |  |  |
|   |  |  |  |  |  |  |  |
|   |  |  |  |  |  |  |  |
|   |  |  |  |  |  |  |  |
|   |  |  |  |  |  |  |  |

WEST

EAST

SOUTH

Location \_\_\_\_\_

Rig up ☒ \_\_\_\_\_

Drilling and remarks:

## RECORD

Cased \_\_\_\_\_ in. \_\_\_\_\_ Ft.

Sand \_\_\_\_\_

Gas \_\_\_\_\_

Oil \_\_\_\_\_

Total Depth \_\_\_\_\_

## PRODUCTION

1st 24 hrs. Nat. \_\_\_\_\_

1st 24 hrs. after shot \_\_\_\_\_

Gas \_\_\_\_\_ Cu. Ft.

Dry Hole \_\_\_\_\_

Abandoned \_\_\_\_\_

Date

JUL 14 1917

191


B. J. Crocker

Scout

Map No. \_\_\_\_\_ Sec. 6 Twp. 76 R. 5Well No. 17. Porter Farm  
Porter Company

NORTH

WEST

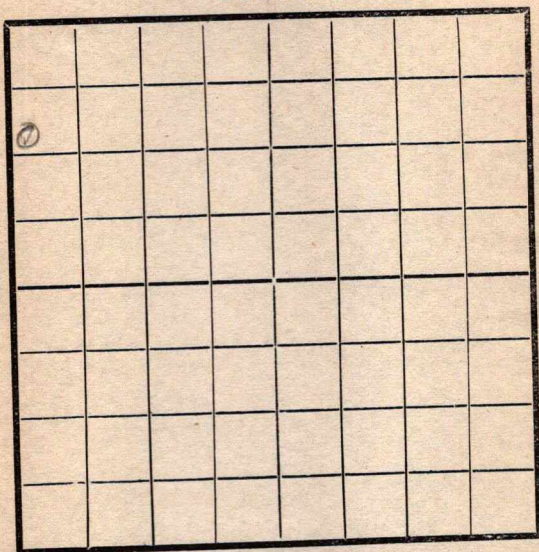

EAST

SOUTH

Location \_\_\_\_\_

Rig Up \_\_\_\_\_

Drilling and remarks

at 2150

## RECORD

Cased \_\_\_\_\_ in. \_\_\_\_\_ Ft.

Sand \_\_\_\_\_

Gas \_\_\_\_\_

Oil \_\_\_\_\_

Total Depth \_\_\_\_\_

## PRODUCTION

1st 24 hrs. Nat. \_\_\_\_\_

1st 24 hrs. after shot \_\_\_\_\_

Gas \_\_\_\_\_ Cu. Ft.

Dry Hole \_\_\_\_\_

Abandoned \_\_\_\_\_

Date

8-23, 1917Lantz


Scout



Map No. \_\_\_\_\_ Sec. 6 Twp. 26 R. 5Well No. 17 Porter Farm \_\_\_\_\_

\_\_\_\_\_ Company \_\_\_\_\_

NORTH

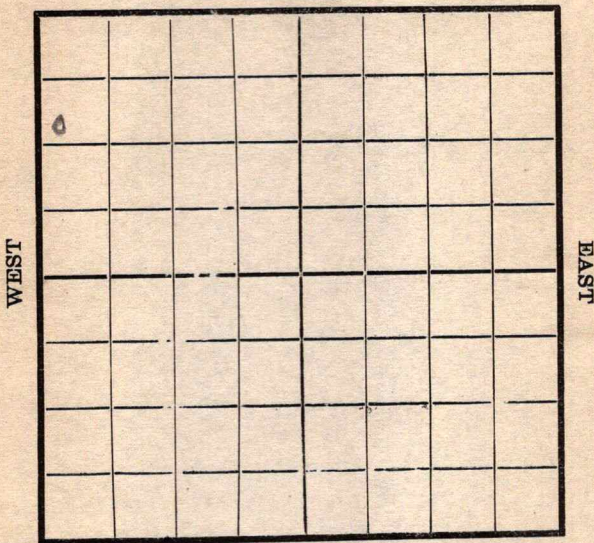

SOUTH

Location \_\_\_\_\_

Rig Up \_\_\_\_\_

Drilling and remarks

*Top sand*  
*2410*

## RECORD

Cased \_\_\_\_\_ in. \_\_\_\_\_ Ft.

Sand \_\_\_\_\_

Gas \_\_\_\_\_

Oil \_\_\_\_\_

Total Depth \_\_\_\_\_

## PRODUCTION

1st 24 hrs. Nat. \_\_\_\_\_

1st 24 hrs. after shot \_\_\_\_\_

Gas \_\_\_\_\_ Cu. Ft.

Dry Hole \_\_\_\_\_

Abandoned \_\_\_\_\_

Date

*9/5*, 191*7* *Conley* Scout \_\_\_\_\_

Map No. \_\_\_\_\_ Sec. 6 Twp. 26 R. 5  
 Well No. 17 Porter Farm \_\_\_\_\_  
Carter Company \_\_\_\_\_

NORTH

WEST

EAST

COMPLETED

SOUTH

Location \_\_\_\_\_

Rig Up \_\_\_\_\_

Drilling and remarks

Est at106013 blv

## RECORD

Cased \_\_\_\_\_ in. \_\_\_\_\_ Ft.

Sand 2400-2465

Gas \_\_\_\_\_

Oil \_\_\_\_\_

Total Depth \_\_\_\_\_

## PRODUCTION

1st 24 hrs. Nat. \_\_\_\_\_

1st 24 hrs. after shot \_\_\_\_\_

Gas \_\_\_\_\_ Cu. Ft.

Dry Hole \_\_\_\_\_

Abandoned \_\_\_\_\_

Date

9/19, 1917

Scout