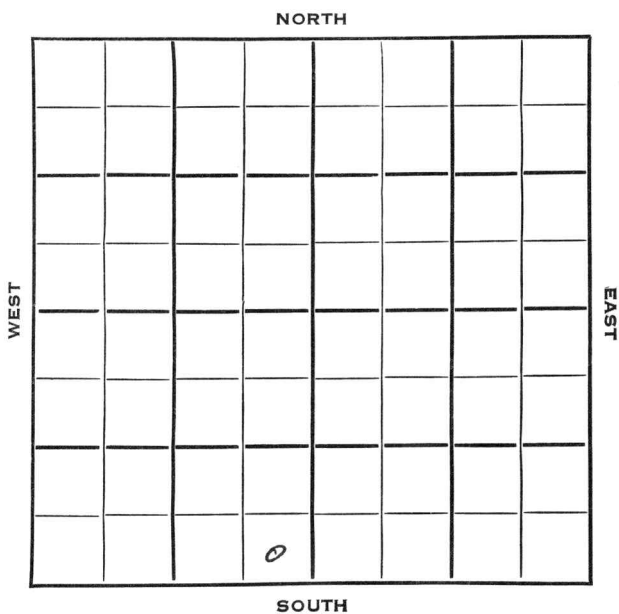


Section 17 Township 26 Range 5EWell No. #169 KooglerCompany Cities Service

Butler KANSAS

SEC. 17	TWP. 26	R. 5 E
------------	------------	-----------

WELL NO.

169 Koogler

FARM

COMPANY

Cities Service

CONTRACTOR

Eldorado Pool


_____ Ft. from N. Line

230 _____ Ft. from S. Line

330 _____ Ft. from E. Line

_____ Ft. from W. Line

SE SE SW

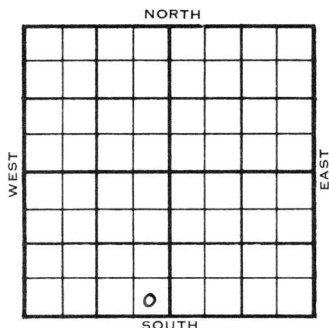

1954

ELEVATION

1331' RB

REPORT

2/10

Oil well TD 2539'
 10" @ 83 Viola 2475' Simp 2499'
 TD 2506' 7" @ 2504 DD 2539'
 Comp. 26 BOPD 163 BW

FIRST REPORT

COMPLETED

County Butler State Kansas

Sec. 17 (Blk. Twp.) 26 (Sur. Rge.) 5E Map No.

Operator Cities Service

Well No. 169 Farm Koogler

Elev. 1331 RB Location SE SE SW

FIRST REPORT

✓

COMPLETE

o

230 Ft. From S Line SW

330 Ft. From E Line Quarter

1st. Report FEB 10 1954

Completion FEB 10 1954

Remarks Eldorado Pool

Spudding Date _____

Drlg. Data Oil well TD 2539

10" @ 83 Viola 2475 Simp. 2499

TD 2506 7" @ 2504 DD 2539

Comp. 26 bopd 163 bw