
Form 51—5M—3-26—22544

Butler

Map No. ____ Sec. 28 Twp. 29 R. 8

Well No. 1 Watkins Farm

Kismet & Emerado Company

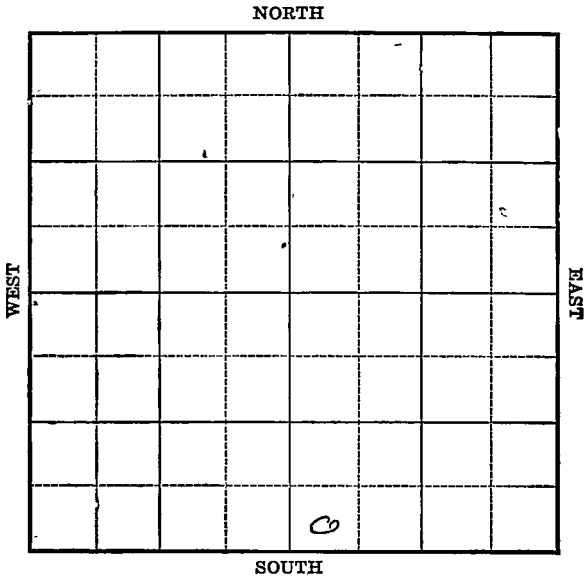

Location

Drilling Remarks

Rig Up

Drilling Remarks

RECORD

Cased ____ in. ____ ft.

Sand

Gas

Oil

Total Depth

PRODUCTION

1st 24 hrs. Nat.

1st 24 hrs. after shot

Gas ____ cu. ft.

Dry Hole


Abandoned

Form 252A—5M—11-25—20913 Butler

Map No. Kan Sec. 28 Twp. 23 R. 8

Well No. 1 Watkins Farm

Kismet & Amerada Company

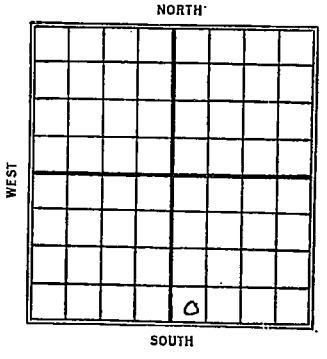

____ Ft. from N. Line

330 Ft. from S. Line

____ Ft. from E. Line

330 Ft. from W. Line

1926

Date	REPORT
9/1	Location
9/15	same
9/22	timbers
9/29	Bldg rig
10/13	Spudding
10/27	Drlg 506'
11/11	" 1050
11/17	" 1500
11/23	" 1715'
12/8	" 2175'
12/15	Sandy shale 2500'-05'
	S.P. 2570'
12/22	S.P. 2640
12/30	H. R. 6" 2640
1927	
1/6	Topline 2740 S.P. 2775
1/12	S & a. 2775

Form 26—1M Bks.—3-23—11959. Butler

15 KANSAS

Map No._____ Sec. 28 Twp. 23 R. 8

Well, No. 1 Watkins

Ismet & Amarada Pet Company

_____ Contractor

FIRST REPORTS


_____Ft. from N. Line

330 Ft. from S. Line

_____Ft. from E. Line

330 Ft. from W. Line


SECTION PLAT

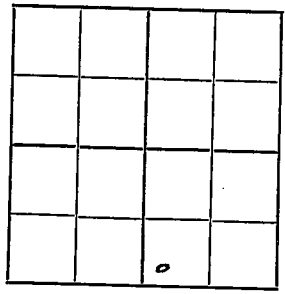

Location ✓

Rig up _____

Drilling and Remarks:

 

RECORD

Cased_____in., _____ ft.

Sand _____

Gas _____

Oil _____

Total Depth _____

PRODUCTION

1st 24 hrs. Nat. _____

1st 24 hrs. after shot _____

Gas _____Cu. Ft.

Dry Hole _____

Abandoned _____

Date

SEP 1 1926

192

CHAS. L. SHERWOOD

_____Scout

Form 32 S.C.O.P.Co.—1M Bks.—2-25—18417 Butler

15 KANSAS

Map No. ____ Sec. 28 Twp. 23 R. 8

Well No. 1 Watkins Farm

Kismet & Emeralda Company

NORTH

WEST

EAST

SOUTH

COMPLETED

ABANDONED

330 x 330

Location ____

Rig up ____

Drilling and Remarks:

Sdy Shale 2500-05

Top lime 2740

DRY 2775

RECORD

Cased ____ in., ____ ft.

Sand ____

Gas ____

Oil ____

Total Depth 2775

PRODUCTION

1st 24 hrs. Nat. ____

1st 24 hrs. after shot ____

Gas ____ ✓ Cu. Ft.

Dry Hole ✓

Abandoned ____

Date JAN 12 1927 192

CHAS. L. SHERWOOD Scout