
Form 51 5M 8-24, 16567

Map No. Kaw Sec. 31 Twp. 23 R. 8

Well No. 1 Watkins Farm

~~Morgan & Moore~~ Company

~~Greenland Oil~~

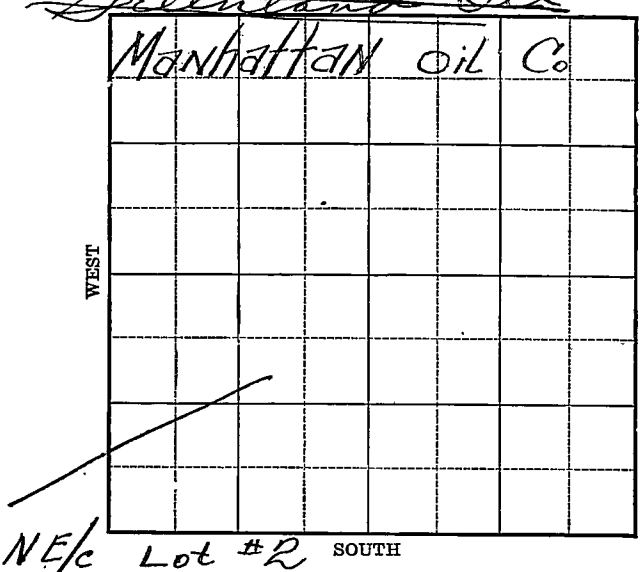

NE/c Lot #2

Location

Drilling Remarks

Rig Up

Drilling Remarks

RECORD

Cased in. ft.

Sand

Gas

Oil

Total Depth

PRODUCTION

1st 24 hrs. Nat.

1st. 24 hrs. after shot

Gas cu. ft.

Dry Hole

Abandoned


Form 252A 5M 8-24 16529

Map No. Kan Sec. 31 Twp. 23 R 8

Well No. 1 Watkins Farm

~~Morgan & Moose~~ Company

~~Greenland Oil~~ Manhattan Oil

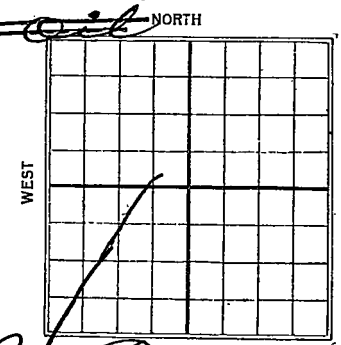

Ft. from N. Line

Ft. from S. Line

Ft. from E. Line

Ft. from W. Line

NE/c Lot 2

Date 1925	REPORT
7/17	R.O.C.
7/24	Spud.
7/31	" "
8/7	"
8/14	"
8/20	Location only.
8/26	"
9/3	"
9/11	"
9/16	"
9/24	"
10/1	"
10/8	"
10/16	"
10/22	"
10/29	"
11/6	"
11/13	"
11/19	"
11/27	"

12/3 ———
12/10 — Blow Rig
12/17 — Spudding
12/23 — Spud. 200'
12/31 — Drlg 240'

1926

1/8 — Drlg 500'
1/14 — ———
1/20 — ✓ 1700'
1/27 — ✓ 2050'
2/4 — Rung 4" 2150'
2/10 — S.D. Top Sand 2640'
no show.
2/17 ———
2/24 Same (and Loc Change ownership)
3/5 — ———
3/10 — ———
3/18 — ———
3/25 — ———
4/1 ———
4/7 ———
4/14 — ———
4/21 — ———
4/30 — ———
5/8 — Same.
5/12 — Same.
5/19 — Rigging up to drill deeper. T.D. 2640'
5/26 T.D. 2760 Top lime 2750 Sh a.

Form 26—1M Bks.—3-23—11959.

Map No. 12 Hobbs Sec. 24 Twp. 23 R. 8


Well No. 1 Wickens

Morgan & Moore Company

Contractor

NE/c Lot #2.

SECTION PLAT

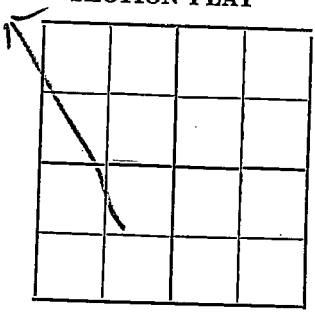

_____Ft. from N. Line

_____Ft. from S. Line

_____Ft. from E. Line

_____Ft. from W. Line

FIRST REPORTS

Location _____

Rig up On ground

Drilling and Remarks:

RECORD

Cased _____ in., _____ ft.

Sand _____

Gas _____

Oil _____

Total Depth _____

PRODUCTION

1st 24 hrs. Nat. _____

1st 24 hrs. after shot _____

Gas _____ Cu. Ft.

Dry Hole _____

Abandoned _____

Date

JUL 17 1925

192____

CHAS. L. SHERWOOD

Scout

Form 26—1M Bks.—3-23—11959. Butler Co

KIS KANSAS Map No. Sec. 31 Twp. 22 R. 8


Well No. 1 Watkins

Foley Land & Oil Co Company

Contractor

NE c Lot #2

SECTION PLAT

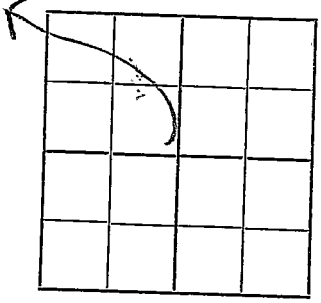

_____Ft. from N. Line

_____Ft. from S. Line

_____Ft. from E. Line

_____Ft. from W. Line

CORRECTION

Location ✓

Rig up

Drilling and Remarks:

chg Ownership to Howe.

RECORD

Cased _____ in., _____ ft.

Sand

Gas

Oil

Total Depth

PRODUCTION

1st 24 hrs. Nat.

1st 24 hrs. after shot

Gas _____ Cu. Ft.

Dry Hole

Abandoned

Date

OCT 8 1925

192 CHAS. L. SHERWOOD Scout

Form 26—1M Bks.—3-23—11959. Butler Co

1615 KANSAS Map No. Sec. 31 Twp. 23 R. 8


Well No. 1 Robinson

Manhattan Oil Co Company

Contractor

NEc lot #2

SECTION PLAT

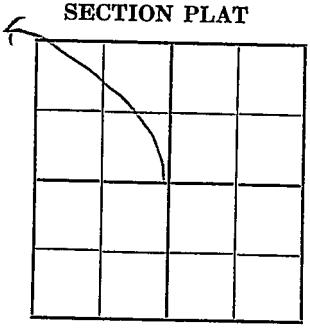

_____Ft. from N. Line

_____Ft. from S. Line

_____Ft. from E. Line

_____Ft. from W. Line

CORRECTION

Location _____

Rig up _____

Drilling and Remarks:

S/D Top ad 2640'

Chg Ownership

to above

RECORD

Cased _____ in., _____ ft.

Sand _____

Gas _____

Oil _____

Total Depth _____

PRODUCTION

1st 24 hrs. Nat. _____

1st 24 hrs. after shot _____

Gas _____ Cu. Ft.

Dry Hole _____

Abandoned _____

Date

FEB 24 1926

192____

CHAS. L. SHERWOOD

Scout

Form 26—1M Bks.—3-23—11959.

Butler

K 15 KANSAS

Map No. ____ Sec. 31 Twp. 33 R. 8

Well No. 1 Watkins

Manhattan Oil Co

Company

Contractor

NE c lot #2

COMPLETED

____Ft. from N. Line


____Ft. from S. Line

____Ft. from E. Line

____Ft. from W. Line

ABANDONED

SECTION PLAT

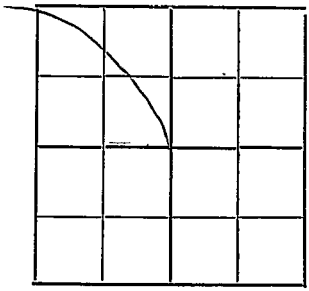

Location ____

Rig up ____

Drilling and Remarks:

Top lime 2750'

DC4

2760'

RECORD

Cased ____ in., ____ ft.

Sand ____

Gas ____

Oil ____

Total Depth 2760'

PRODUCTION

1st 24 hrs. Nat. ____

1st 24 hrs. after shot ____

Gas ____ Cu. Ft.

Dry Hole ____

Abandoned ____

Date

MAY 26 1926

192

CHAS. L. SHERWOOD

Scout

Can't read your writing.
Map shows Philip Scarf as
the owner of this.
D.P.

Returned D.P.
Cards
Tracing
France-Map
Scarborough Map
Moody Map
Scarborough Plat Book
Moody Plat Book