
Form 51—5M—10-26—Mid-West

Map No. Kansas Sec. 34 Twp. 23 R. 8 E Grunwood

Well No. 1 G. A. Mosby Farm

Buck etal Company

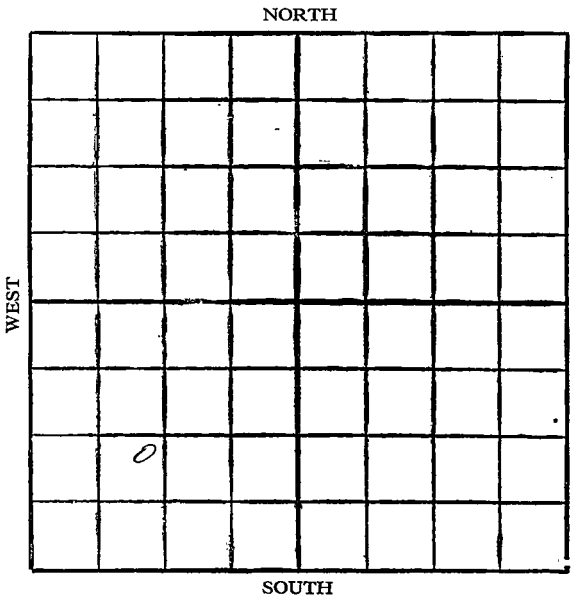


Location	Rig Up
Drilling Remarks	Drilling Remarks
RECORD	PRODUCTION
Cased in. ft.	1st 24 hrs. Nat.
Sand	1st 24 hrs. after shot
Gas	Gas cu. ft.
Oil	Dry Hole
Total Depth	Abandoned

Form 252A—5M—4-27—27425 Greenwood

Map No. ____ Sec. 34 Twp. 23 R. 8 E

Well No. 1 — J. A. Mosley Farm

Buckeetal Company

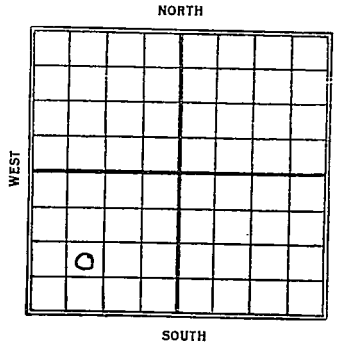

____ Ft. from N. Line

990 Ft. from S. Line

____ Ft. from E. Line

990 Ft. from W. Line

1927

Date	REPORT
5/5	R O G
5/12	Rig
5/18	—"
5/25	—"
6/1	—"
6/7	Spudg
6/15	Drlg 400
6/22	" 1100
6/29	S.D. 1360
7/7	Drlg 1360
7/13	Drlg 1600
7/20	underreaming 1650.
7/28	S.D. 2110 - Tittles
8/4	Drlg 2285
8/10	Broken sand 2440 - 2525 - Drilling 2651 -
8/18	Pkn. sand 2440 - 2525 top lime 2636 T.D. 2651

Form 26—1M Bks.—3-23—11959. Sherwood Co E

15 KANSAS Map No. _____ Sec. 34 Twp. 23 R. 8

Well No. 1 S. A. Mosby.

Buck et al Company

_____ Contractor

FIRST REPORTS


_____ Ft. from N. Line

990 Ft. from S. Line

_____ Ft. from E. Line

990 Ft. from W. Line

SECTION PLAT

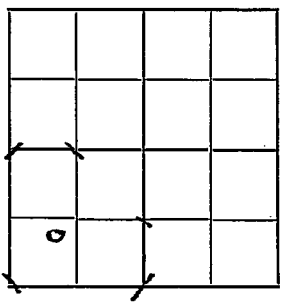

Location _____

Rig up _____

Drilling and Remarks:

R.O.S.

RECORD

Cased _____ in., _____ ft.

Sand _____

Gas _____

Oil _____

Total Depth _____

PRODUCTION

1st 24 hrs. Nat. _____

1st 24 hrs. after shot _____

Gas _____ Cu. Ft.

Dry Hole _____

Abandoned _____

Date MAY 5 1927

192

CHAS. L. SHERWOOD

Scout

Form 26—1M Bks.—3-23—11959. Sherwood

K15 KANSAS

Map No. _____ Sec. 24 Twp. 23 R. 8

Well No. 1 S. A. Mosby

Duck @ TAL Company

_____ Contractor

COMPLETED


_____ Ft. from N. Line

990 Ft. from S. Line

_____ Ft. from E. Line

990 Ft. from W. Line

SECTION PLAT

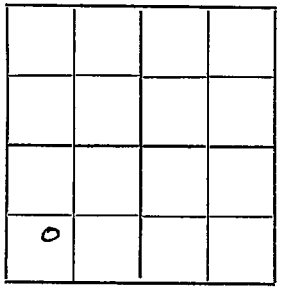

Location _____

Rig up _____

Drilling and Remarks:

Broken Sq 2440-2535

Top Lime 2636

Sd 2651

RECORD

Cased _____ in., _____ ft.

Sand _____

Gas _____

Oil _____

Total Depth 2651

PRODUCTION

1st 24 hrs. Nat. _____

1st 24 hrs. after shot _____

Gas _____ Cu. Ft.

Dry Hole ✓

Abandoned ✓

Date AUG 18 1927

192

CHAS. L. SHERWOOD

Scout