
Form 51—5M—4-27—27423

KANSAS

Map No. ____ Sec. 34 Twp. 22 R. 8E

Well No. 5 Mosby Farm

Prairie Oil & Gas Company

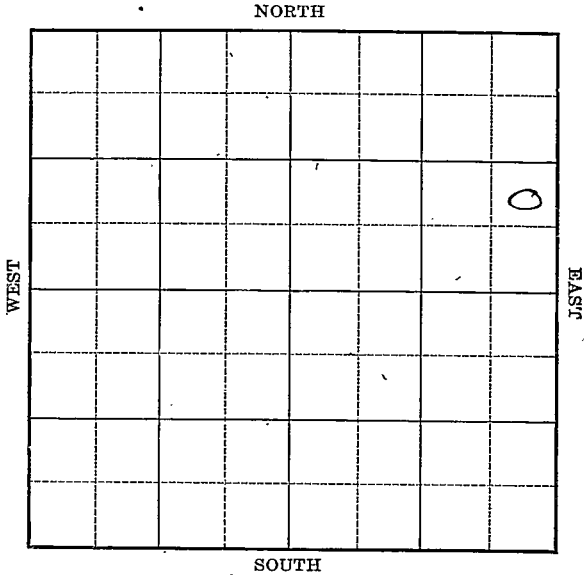

Location ____

Drilling Remarks

Rig Up ____

Drilling Remarks

RECORD

Cased ____ in. ____ ft.

Sand ____

Gas ____

Oil ____

Total Depth ____

PRODUCTION

1st 24 hrs. Nat. ____

1st 24 hrs. after shot ____

Gas ____ cu. ft.

Dry Hole ____


Abandoned ____

Form 252A—5M—4-27—27425

Map No. KANSAS Sec. 34 Twp. 23 R. 8 E

Well No. 1— Mosby Farm

Prairie O. & G. Company

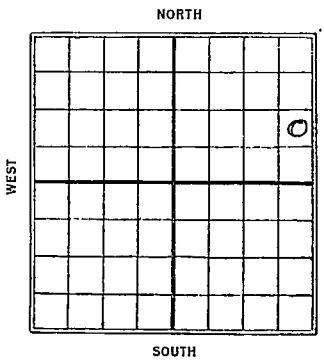

_____ Ft. from N. Line

990 Ft. from S. Line

330 Ft. from E. Line

_____ Ft. from W. Line

1928

Date	REPORT
4/12	R.O.G.
4/19	Lumbers
4/26	—
5/3	Bldg rig
5/10	Rig
5/18	Drlg 385
5/24	" 750
5/31	" 970'
6/7	" 1355
6/14	" 1750
6/21	" 2000
6/28	sdy shale 2427-79-Hfw lm & a. ~~2474~~
7/5	Correct T.D. to 2497'

Form 26—1M Bks.—3-23—11959.

Map No. 15 KANSAS Sec. 34 Twp. 23 R. 8 E

Well No. 1 Mosby

Prairie Oil & Gas Co. Company

_____ Contractor

FIRST REPORTS


_____ Ft. from N. Line

990 Ft. from S. Line

330 Ft. from E. Line

_____ Ft. from W. Line

SECTION PLAT

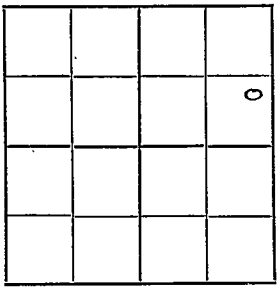

Location _____

Rig up _____

Drilling and Remarks:

R.S.

RECORD

Cased _____ in., _____ ft.

Sand _____

Gas _____

Oil _____

Total Depth _____

PRODUCTION

1st 24 hrs. Nat. _____

1st 24 hrs. after shot _____

Gas _____ Cu. Ft.

Dry Hole _____

Abandoned _____

Date

APR 12 1928, 192

CHAS. L. SHERWOOD

Scout

Form 20 [illegible] Bks.—3-23—11959. Sherwood

KANSAS Map No. _____ Sec. 34 Twp. 23 R. 8


Well No. 1 Mosby

Prairie Oil & Gas Co. Company

_____ Contractor

Leon S. COMPLETED

SECTION PLAT

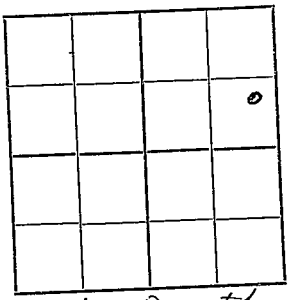

_____ Ft. from N. Line

990 Ft. from S. Line

330 Ft. from E. Line

_____ Ft. from W. Line

correction on Total Depth

Location _____

Rig up _____

Drilling and Remarks:

Pres reported as TD 1479' Chgd to 1497'

RECORD

Cased _____ in., _____ ft.

Sand _____

Gas _____

Oil _____

Total Depth 1497'

PRODUCTION

1st 24 hrs. Nat. _____

1st 24 hrs. after shot _____

Gas _____ Cu. Ft.

Dry Hole V

Abandoned V

Date JUL 5 1928 192___

CHAS. L. SHERWOOD Scout

Form 26—[illegible] Bks.—3-23—11959.

S/Mwood

KIOWA NSAS Map No. _____ Sec. 34 Twp. 23 R. 8

Well No. 1 Mosby

Prairie Oil & Gas Company

_____ Contractor

COMPLETED

_____ Ft. from N. Line


990 Ft. from S. Line

330 Ft. from E. Line

_____ Ft. from W. Line

ABANDONED

SECTION PLAT

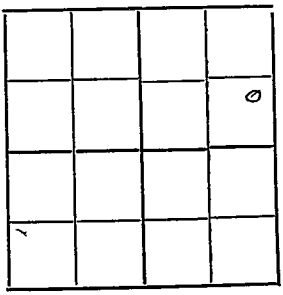

Location _____

Rig up _____

Drilling and Remarks:

Sdy Shale 2477-79'

Dfw

Dfw

RECORD

Cased _____ in., _____ ft.

Sand _____

Gas _____

Oil _____

Total Depth 2479

PRODUCTION

1st 24 hrs. Nat. _____

1st 24 hrs. after shot _____

Gas _____ Cu. Ft.

Dry Hole ✓

Abandoned ✓

Date JUN 23 1928

CHAS. L. SHERWOOD

_____ Scout

102