
Form 51—5-19—5M—Mid-West

Map No._____ Sec. 17 Twp. 26 R. 5

Well No. 9 McClelper Farm

Empire Company

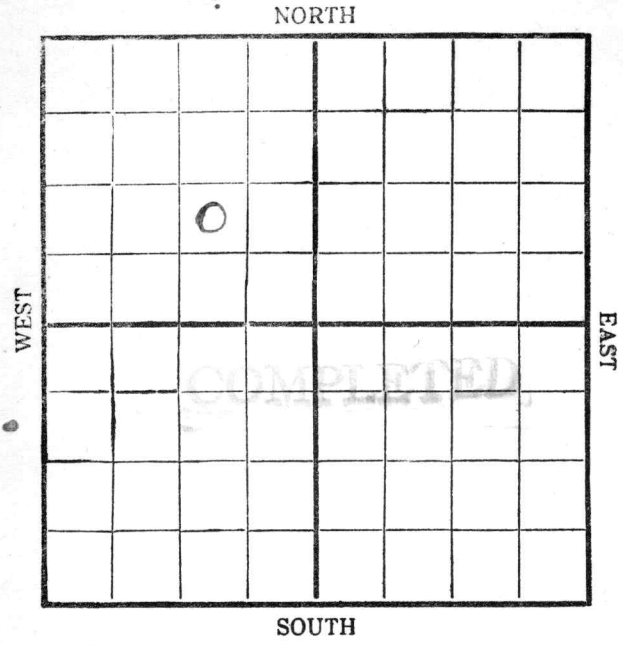

Location _____

Drilling Remarks:

Rig Up _____

Drilling Remarks:

RECORD

Cased _____ in. _____ ft.

Sand _____

Gas _____

Oil _____

Total Depth _____

PRODUCTION

1st 24 hrs. Nat. _____

1st 24 hrs. after shot _____

Gas _____ cu. ft.

Dry Hole _____

Abandoned _____

Form 252A 2M-10-19 CroMac.

Map No. _____ Sec. 17 Twp. 26 R. 5

Well No. 9. Nickelger Farm

Empire Gas & Fuel Co Company

_____ Contractor


NW. Quarter

_____ Ft. from N. Line

990 Ft. from S. Line

990 Ft. from E. Line

_____ Ft. from W. Line

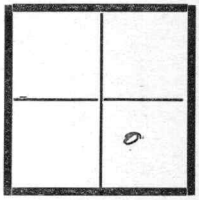

DATE	REPORT
~~10/19~~	
10/27	7390 - 2439' - H. & Bge.

COMPLETED


Form 26—1M Books of 100 Sheets Each—4-15-18

Map No. K14 Sec. 17 Twp. 26 R. 5

Well No. 9 Nicholson

Empire Company

Contractor

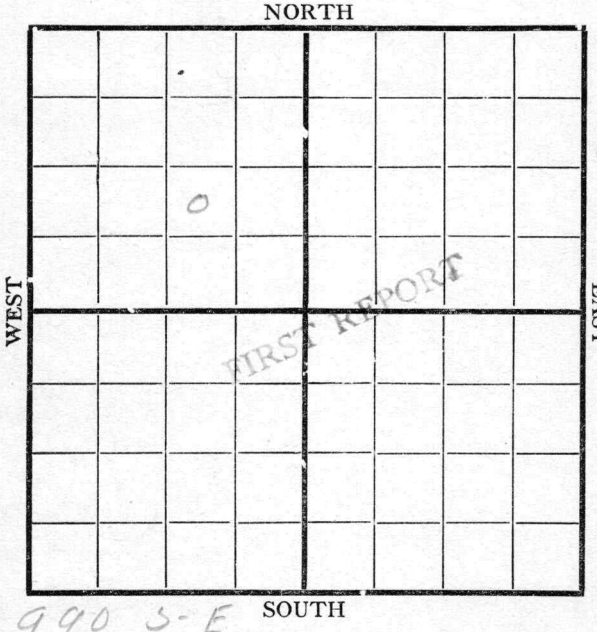

Location

Rig up ✓

Drilling and Remarks:

RECORD

Cased in., ft.

Sand

Gas

Oil

Total Depth

PRODUCTION

1st 24 hrs. Nat.

1st 24 hrs. after shot

Gas Cu. Ft.

Dry Hole

Abandoned

Date

7/19 191 9. Coyle Scout

Form 26—1M—4-19—Mid-West


Map No. K14 Sec. 17 Twp. 26 R. 5

Well No. 9 Michelsen

Empire Company

Contractor

SECTION PLAT

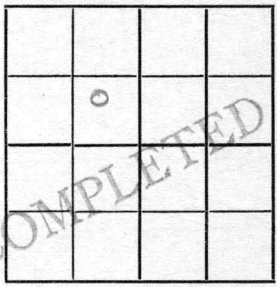

Ft. from N. Line

990 Ft. from S. Line

990 Ft. from E. Line

Ft. from W. Line

Location

Rig up

Drilling and Remarks:

RECORD

Cased in., ft.

Sand 2390 - 2439

Gas

Oil

Total Depth

PRODUCTION

1st 24 hrs. Nat. 40 bbls

1st 24 hrs. after shot

Gas Cu. Ft.

Dry Hole

Abandoned

Date

10/27/1919

Pyle Scout