

Map No. 30 Sec 31 Twp. 25 R. 5


Well No. 5 Murphy Farm

Empire Company

NORTH

WEST

EAST

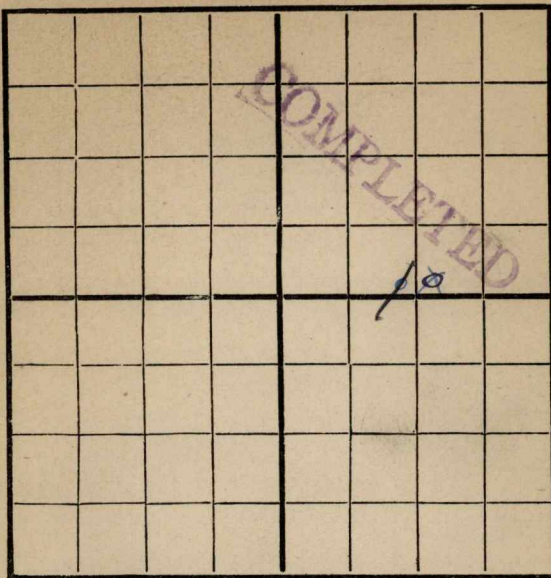

SOUTH

Location _____

Rig Up _____

Drilling Remarks:

Drilling Remarks:

7/22-870
 9/26-1560-S.D.
 10/3-1560-S.D.
 11/9-11/14-11/27-12/4-12/11-12/18-12/25-12/30-12/31
 1/8 Abandoned

RECORD

PRODUCTION

Cased _____ in _____ Ft.

1st 24 hrs. Nat. _____

Sand _____

1st 24 hrs. after shot _____

Gas _____

Gas _____ Cu. Ft.

Oil _____

Dry Hole _____


Total Depth _____

Abandoned _____

Map No. _____ Sec. 31 Twp. 25 R. 5
 Well No. Miner's Farm _____
Empire Fuel & Oil Co. Company _____

NORTH

WEST

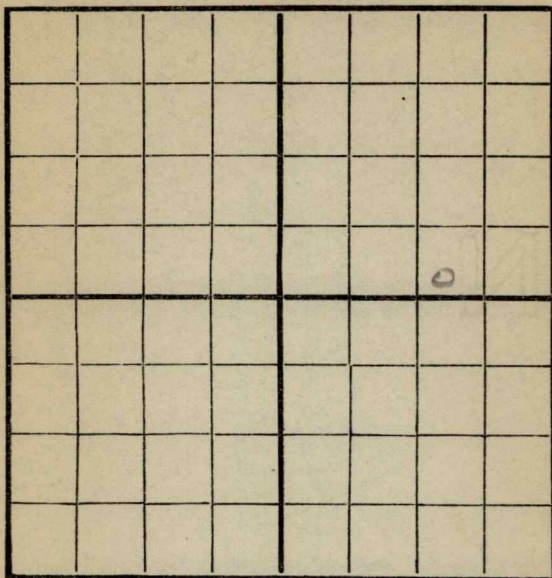

EAST

SOUTH

Location _____
 Rig Up ✓ _____
 Drilling and remarks _____

RECORD

Cased _____ in. _____ Ft.
 Sand _____
 Gas _____
 Oil _____
 Total Depth _____

PRODUCTION

1st 24 hrs. Nat. _____
 1st 24 hrs. after shot _____
 Gas _____ Cu. Ft.
 Dry Hole _____
 Abandoned _____

Date


6/1, 1916 Scout Scout

Map No. _____ Sec. 31 Twp. 25 R. 5
 Well No. 5 Humphrey Farm _____
 _____ Company _____

NORTH

WEST

EAST

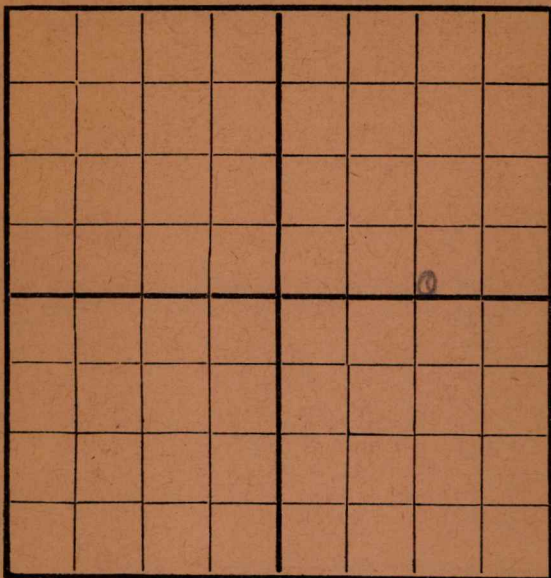

SOUTH

Location _____
 Rig Up _____
 Drilling and remarks _____

424 150'

RECORD

Cased _____ in. _____ Ft.
 Sand _____
 Gas _____
 Oil _____
 Total Depth _____

PRODUCTION

1st 24 hrs. Nat. _____
 1st 24 hrs. after shot _____
 Gas _____ Cu. Ft.
 Dry Hole _____
 Abandoned _____

Date

424, 1916 Alcazar Scout

Map No. _____ Sec. 31 Twp. 25 R. 5
 Well No. 5 _____ Farm _____
 _____ Company _____

NORTH

WEST

EAST

SOUTH

Location _____
 Rig Up _____
 Drilling and remarks _____

RECORD

Cased _____ in. _____ Ft.
 Sand _____
 Gas _____
 Oil _____
 Total Depth _____

PRODUCTION

1st 24 hrs. Nat. _____
 1st 24 hrs. after shot _____
 Gas _____ Cu. Ft.
 Dry Hole _____
 Abandoned _____


Date

7/6, 1916 Scout

Map No. _____ Sec. 31 Twp. 25 R. 5
 Well No. 5 Murphy Farm _____
Engine Company _____

NORTH

WEST

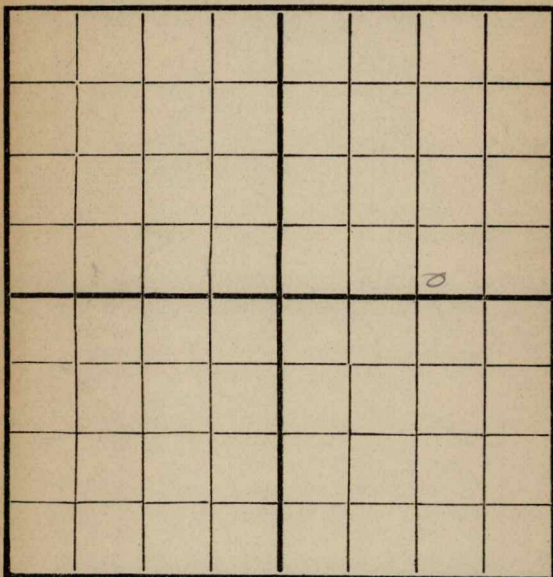

EAST

SOUTH

Location _____

Rig Up _____

Drilling and remarks

870'

RECORD

Cased _____ in. _____ Ft.

Sand _____

Gas _____

Oil _____

Total Depth _____

PRODUCTION

1st 24 hrs. Nat. _____

1st 24 hrs. after shot _____

Gas _____ Cu. Ft.

Dry Hole _____

Abandoned _____

Date

7/2/2, 1916 [Signature]

Scout

Map No. _____ Sec. 31 Twp. 25 R. 5
Well No. 5 Murphy Farm _____
Empire Company _____

NORTH

WEST

EAST

SOUTH

Location -----
Rig Up -----
Drilling and remarks -----

1180

RECORD

Cased _____ in. _____ Ft.
 Sand _____
 Gas _____
 Oil _____
 Total Depth _____

PRODUCTION

1st 24 hrs. Nat. _____
1st 24 hrs. after shot _____
Gas _____ Cu. Ft. _____
Dry Hole _____
Abandoned _____

Date _____

Date 8/3, 1916 W. L. L. L. L. Scout

Map No. _____ Sec. 31 Twp. 25 R. 5
 Well No. 5 Murphy Farm _____
Emple Company _____

NORTH

WEST

EAST

SOUTH

Location _____
 Rig Up _____
 Drilling and remarks _____

RECORD

Cased _____ in. _____ Ft.
 Sand _____
 Gas _____
 Oil _____
 Total Depth _____

PRODUCTION

1st 24 hrs. Nat. _____
 1st 24 hrs. after shot _____
 Gas _____ Cu. Ft.
 Dry Hole _____
 Abandoned _____


Date

8/9, 1916 Alley Scout

Map No. _____ Sec. 31 Twp. 25 R. 5
 Well No. 5 simply _____ Farm _____
Ensign _____ Company _____

NORTH

WEST

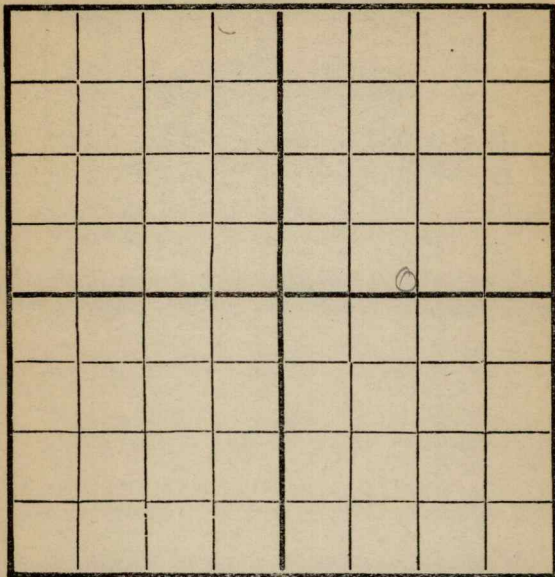

EAST

SOUTH

Location _____
 Rig Up _____
 Drilling and remarks _____

1560

RECORD

Cased _____ in. _____ Ft.
 Sand _____
 Gas _____
 Oil _____
 Total Depth _____

PRODUCTION

1st 24 hrs. Nat. _____
 First 24 hrs. after shot _____
 Gas _____ Cu. Ft.
 Dry Hole _____
 Abandoned _____

Date

8/5, 1916 _____ Scout _____

Map No. _____ Sec. 31 Twp. 25 R. 5


Well No. 5 Humphreys Farm _____

Empire Company _____

NORTH

WEST

EAST

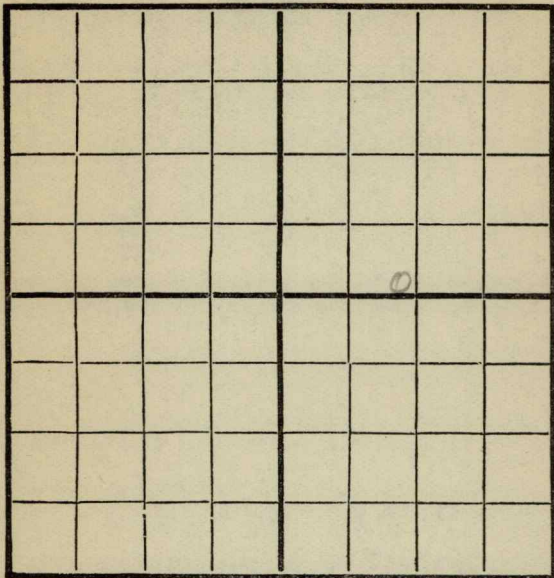

SOUTH

Location _____

Rig Up _____

Drilling and remarks

Shut Down
11/560

RECORD

Cased _____ in. _____ Ft.

Sand _____

Gas _____

Oil _____

Total Depth _____

PRODUCTION

1st 24 hrs. Nat. _____

First 24 h.s. after shot _____

Gas _____ Cu. Ft.

Dry Hole _____

Abandoned _____

Date

11/22, 1915 *Acadiff* Scout

Map No. _____ Sec. 31 Twp. 25 R. 5Well No. 4 Murphy Farm _____Engine Company _____

NORTH

WEST

EAST

SOUTH

Location _____

Rig Up _____

Drilling and remarks

2550

RECORD

Cased _____ in. _____ Ft.

Sand _____

Gas _____

Oil _____

Total Depth _____

PRODUCTION

1st 24 hrs. Nat. _____

First 24 h.s. after shot _____

Gas _____ Cu. Ft.

Dry Hole _____

Abandoned _____

Date


8/22/1916 R. C. Campbell Scout

Map No. _____ Sec. 31 Twp. 25 R. 5
 Well No. 5 Murphy Farm _____
Empire Company _____

NORTH

WEST

EAST

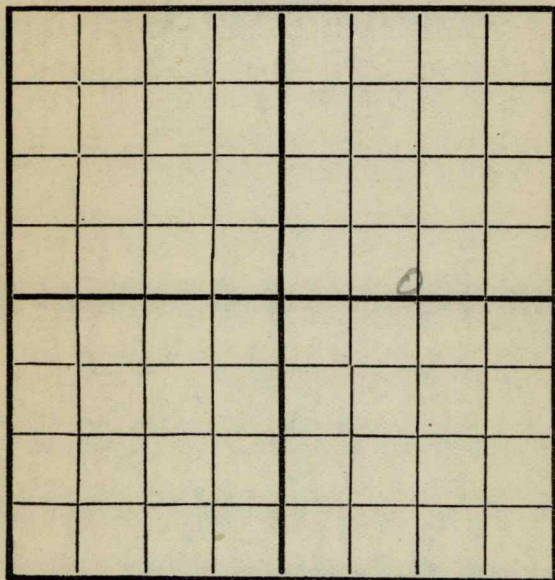

SOUTH

Location _____
 Rig Up _____
 Drilling and remarks _____

Shut Down
1560

RECORD

Cased _____ in. _____ Ft.
 Sand _____
 Gas _____
 Oil _____
 Total Depth _____

PRODUCTION

1st 24 hrs. Nat. _____
 1st 24 hrs. after shot _____
 Gas _____ Cu. Ft.
 Dry Hole _____
 Abandoned _____


Date _____

_____, 191____ Scout _____

Map No. _____ Sec. 31 Twp. 25 R 5Well No. 5 Murphy Farm _____
E. Murphy Company _____

NORTH

WEST

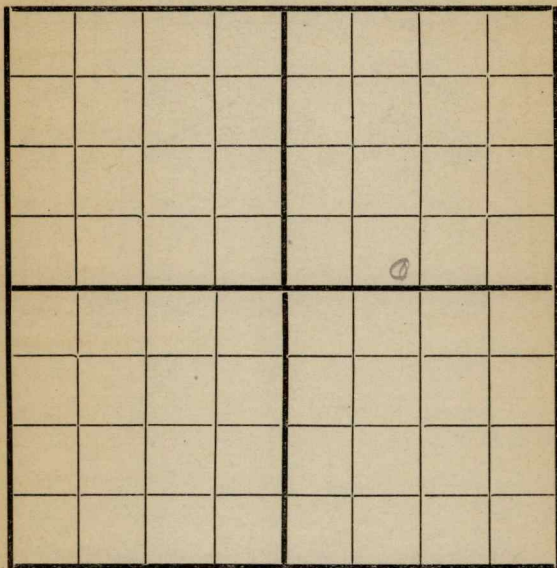

EAST

SOUTH

Location _____

Rig Up _____

Drilling and remarks

*Shut down
at 1560*

RECORD

Cased _____ in. _____ Ft.

Sand _____

Gas _____

Oil _____

Total Depth _____

PRODUCTION

1st 24 hrs. Nat. _____

1st 24 hrs. after shot _____

Gas _____ Cu. Ft.

Dry Hole _____

Abandoned _____

Date


9/6, 191 *6* *Leander* Scout

Map No. _____ Sec. 31 Twp. 25 R. 5
 Well No. 4 Murphy Farm _____
Empire Company _____

NORTH

WEST

EAST

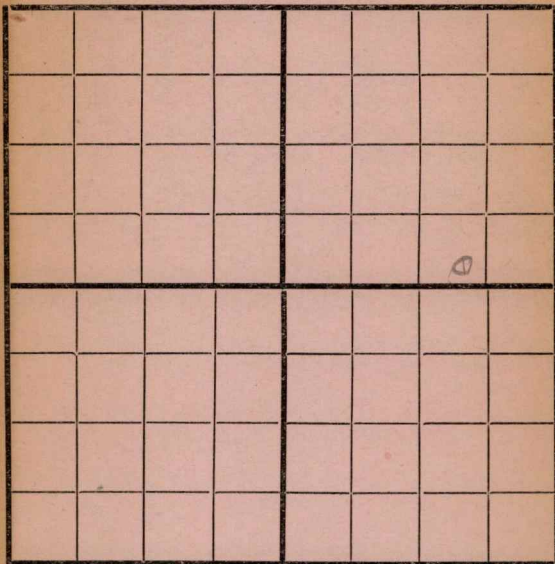

SOUTH

Location _____

Rig Up _____

Drilling and remarks

2765

RECORD

Cased _____ in. _____ Ft.

Sand _____

Gas _____

Oil _____

Total Depth _____

PRODUCTION

1st 24 hrs. Nat. _____

1st 24 hrs. after shot _____

Gas _____ Cu. Ft.

Dry Hole _____

Abandoned _____

Date


9/6, 1916 Lead Scout

Map No. _____ Sec. 31 Twp. 25 R. 5
 Well No. 5 _____ Farm _____
Empire _____ Company _____

NORTH

WEST

EAST

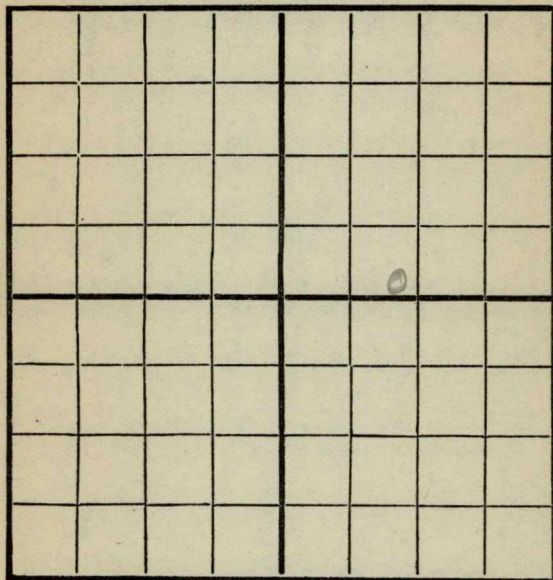

SOUTH

Location _____
 Rig Up _____
 Drilling and remarks _____

*Shut Down
 at 1560*

RECORD

Cased _____ in. _____ Ft.
 Sand _____
 Gas _____
 Oil _____
 Total Depth _____

PRODUCTION

1st 24 hrs. Nat. _____
 1st 24 hrs. after shot _____
 Gas _____ Cu. Ft.
 Dry Hole _____
 Abandoned _____

Date 9/13 1916 Alfred J. Scout Scout

Map No. _____ Sec. 31 Twp. 25 R. 5
 Well No. 5 Murphy Farm _____
Carpine Company _____

NORTH

WEST

EAST

SOUTH

Location _____

Rig Up _____

Drilling and remarks

Shut Down
at 1560

RECORD

Cased _____ in. _____ Ft.

Sand _____

Gas _____

Oil _____

Total Depth _____

PRODUCTION

1st 24 hrs. Nat. _____

1st 24 hrs. after shot _____

Gas _____ Cu. Ft.

Dry Hole _____

Abandoned _____


Date

9/20 1916 B. Carson Scout

Map No. _____ Sec. 31 Twp. 25 R. 5
 Well No. 5 Murphy Farm _____
Carpine Company _____

NORTH

WEST

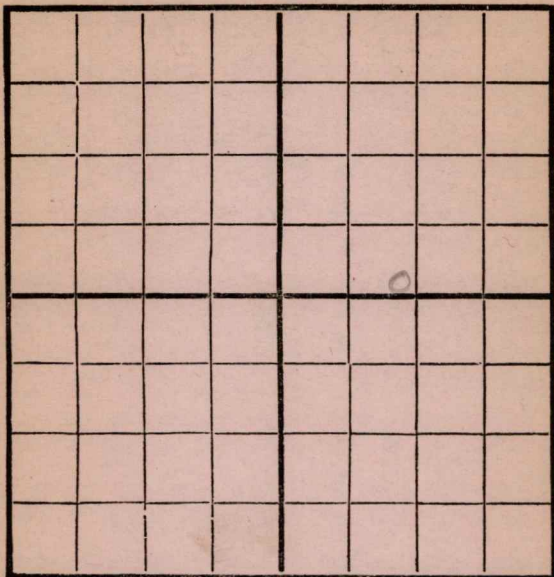

EAST

SOUTH

Location _____
 Rig Up _____
 Drilling and remarks _____

Shut Down
1560

RECORD

Cased _____ in. _____ Ft.
 Sand _____
 Gas _____
 Oil _____
 Total Depth _____

PRODUCTION

1st 24 hrs. Nat. _____
 First 24 hrs. after shot _____
 Gas _____ Cu. Ft.
 Dry Hole _____
 Abandoned _____

Date

9/26, 1916 Scout

Map No. _____ Sec. 31 Twp. 25 R. 5Well No. 5 Murphy Farm _____
Empire Company _____

NORTH

WEST

EAST

SOUTH

Location _____

Rig Up _____

Drilling and remarks

Shut Down
at 1560

RECORD

Cased _____ in. _____ Ft.

Sand _____

Gas _____

Oil _____

Total Depth _____

PRODUCTION

1st 24 hrs. Nat. _____

First 24 hrs. after shot _____

Gas _____ Cu. Ft.

Dry Hole _____

Abandoned _____

Date

10/3, 1916 Scout

Map No. _____ Sec. 31 Twp. 25 R. 5
Well No. 5 _____ Farm _____
Empire _____ Company _____
NORTH

WEST

EAST

SOUTH

0

Location _____
Rig Up _____
Drilling and remarks _____

Shut Down

RECORD

Cased _____ in. _____ Ft.
 Sand _____
 Gas _____
 Oil _____
 Total Depth _____

PRODUCTION

1st 24 hrs. Nat. _____
 1st 24 hrs. after shot _____
 Gas _____ Cu. Ft. _____
 Dry Hole _____
 Abandoned _____

Date _____


Date 10/11, 1916 Scout

Map No. _____ Sec. 31 Twp. 25 R. 5
 Well No. 5 Murphy Farm _____
Enterprise Company _____

NORTH

WEST

EAST

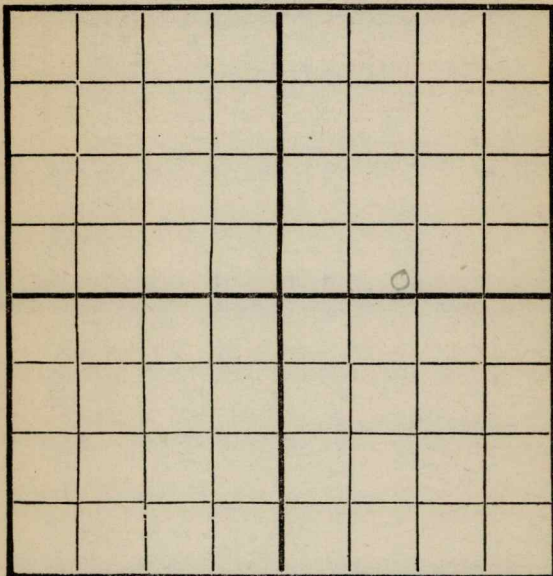

SOUTH

Location _____
 Rig Up _____
 Drilling and remarks _____

*Shut down
at 1560*

RECORD

Cased _____ in. _____ Ft.
 Sand _____
 Gas _____
 Oil _____
 Total Depth _____

PRODUCTION

1st 24 hrs. Nat. _____
 First 24 hrs. after shot _____
 Gas _____ Cu. Ft.
 Dry Hole _____
 Abandoned _____

Date 10/18, 1916 W. R. R. R. Scout _____

Map No. _____ Sec. 31 Twp. 25 R. 5Well No. 5 _____ Farm _____

_____ Company _____

NORTH

WEST

EAST

SOUTH

Location _____

Rig Up _____

Drilling and remarks

Shut Down

RECORD

Cased _____ in. _____ Ft.

Sand _____

Gas _____

Oil _____

Total Depth _____

PRODUCTION

1st 24 hrs. Nat. _____

1st 24 hrs. after shot _____

Gas _____ Cu. Ft.

Dry Hole _____

Abandoned _____


Date

1925, 191 6 *Alley* Scout

Map No. _____ Sec. 31 Twp. 25 R. 5Well No. 5 Murphy Farm _____Cummins Company _____

NORTH

WEST

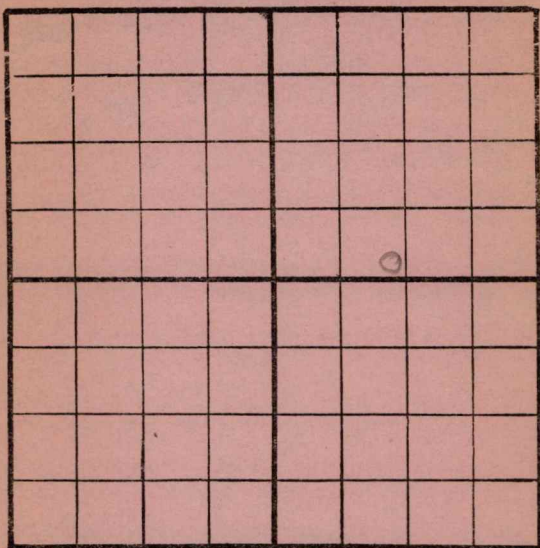

EAST

SOUTH

Location _____

Rig up _____

Drilling and remarks

Shut Down

RECORD

Cased _____ in. _____ Ft.

Sand _____

Gas _____

Oil _____

Total Depth _____

PRODUCTION

1st. 24 hrs. Nat. _____

1st 24 hrs. after shot _____

Gas _____ Cu. Ft.

Dry Hole _____

Abandoned _____

Date

10/30, 1916, Scout

Map No. _____ Sec. 31 Twp. 25 R. 5
Well No. 5 _____ Farm _____
Cummins _____ Company _____

NORTH

WEST

EAST

SOUTH

Location _____

Rig Up-----

Drilling and remarks

Shut Down

RECORD

Cased_____in. _____Ft.

Sand_____

Gas_____

Oil

Total Depth_____

PRODUCTION

1st 24 hrs. Nat. _____

1st 24 hrs. after shot_____

Gas-----Cu. Ft.

Dry Hole_____

Abandoned_ _ _ _ _

Date _____

Date 11/9, 1916 Scout

Scout

Map No. _____ Sec. 31 Twp. 25 R. 5
 Well No. 5 Murphy Farm _____
Engineer Company _____

NORTH

WEST

EAST

SOUTH

Location _____

Rig Up _____

Drilling and remarks

Shut Down
1560

RECORD

Cased _____ in. _____ Ft.

Sand _____

Gas _____

Oil _____

Total Depth _____

PRODUCTION

1st 24 hrs. Nat. _____

First 24 hrs. after shot _____

Gas _____ Cu. Ft.

Dry Hole _____

Abandoned _____

Date

11/14, 191 *6* *Scout* Scout

Map No. _____ Sec. 31 Twp. 25 R. 5
 Well No. 5 Murphy Farm _____
Empire Company _____

NORTH

WEST

EAST

SOUTH

Location _____
 Rig Up _____
 Drilling and remarks _____

RECORD

Cased _____ in. _____ Ft.
 Sand _____
 Gas _____
 Oil _____
 Total Depth _____

PRODUCTION

1st 24 hrs. Nat. _____
 1st 24 hrs. after shot _____
 Gas _____ Cu. Ft.
 Dry Hole _____
 Abandoned _____

Date

11/30 191 6 Conley Scout

*Shut Down
at 1560*

Map No. _____ Sec. 31 Twp. 25 R. 5
 Well No. 5 Murphy Farm _____
Carpis Company _____

NORTH

WEST

EAST

SOUTH

Location _____
 Rig Up _____
 Drilling and remarks _____

Shut Down
1560'

RECORD

Cased _____ in. _____ Ft.
 Sand _____
 Gas _____
 Oil _____
 Total Depth _____


PRODUCTION

1st 24 hrs. Nat. _____
 1st 24 hrs. after shot _____
 Gas _____ Cu. Ft.
 Dry Hole _____
 Abandoned _____

Date

11/27 1916 Carpis Scout

Map No. _____ Sec. 31 Twp. 25 R. 5
 Well No. 5 Murphy Farm _____
Empire Company _____
 NORTH

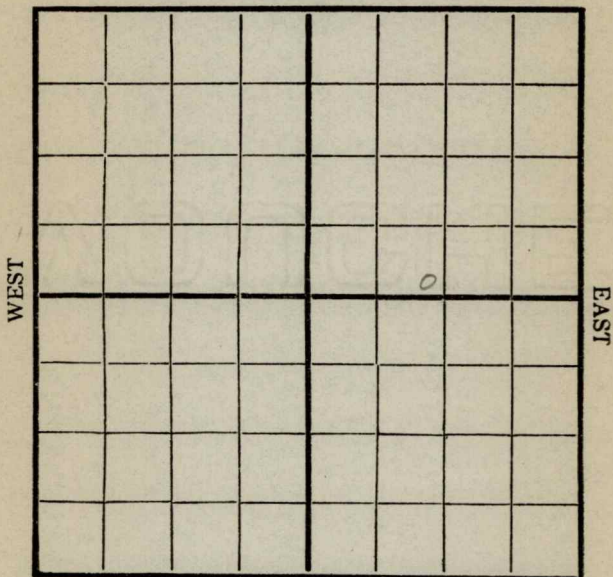

SOUTH

Location _____
 Rig Up _____
 Drilling and remarks _____

*Shut Down
 at 1560*

RECORD

Cased _____ in. _____ Ft.
 Sand _____
 Gas _____
 Oil _____
 Total Depth _____

PRODUCTION

1st 24 hrs. Nat. _____
 1st 24 hrs. after shot _____
 Gas _____ Cu. Ft.
 Dry Hole _____
 Abandoned _____


Date 12/4, 1916, C. C. C. Scout _____

Map No. _____ Sec. 31 Twp. 25 R. 5
 Well No. 5 Murphy Farm _____
Consigne Company _____

NORTH

WEST

EAST

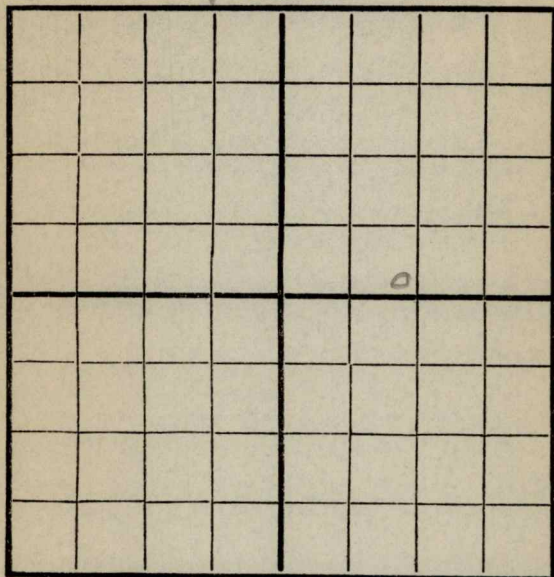

SOUTH

Location _____

Rig Up _____

Drilling and remarks

1560'

RECORD

Cased _____ in. _____ Ft.

Sand _____

Gas _____

Oil _____

Total Depth _____

PRODUCTION

1st 24 hrs. Nat. _____

1st 24 hrs. after shot _____

Gas _____ Cu. Ft.


Dry Hole _____

Abandoned _____

Date

12/11, 1916, Consigne Scout

Map No. _____ Sec. 31 Twp. 25 R. 5
 Well No. 5 Murphy Farm _____
Empire Company _____
 NORTH

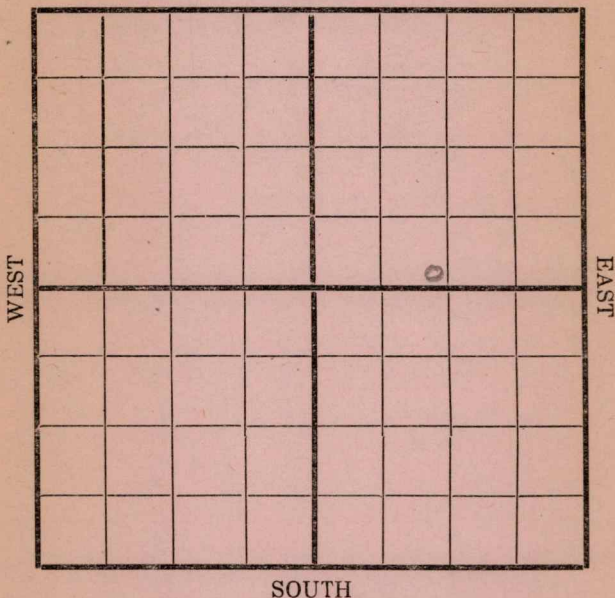

Location _____
 Rig Up _____
 Drilling and remarks _____

Shut Down
at 1560

RECORD

Cased _____ in. _____ Ft.
 Sand _____
 Gas _____
 Oil _____
 Total Depth _____

PRODUCTION

1st 24 hrs. Nat. _____
 1st 24 hrs. after shot _____
 Gas _____ Cu. Ft.
 Dry Hole _____
 Abandoned _____


Date

12/18 6 191 *Conley* Scout

Map No. _____ Sec. 31 Twp. 25 R. 5
Well No. 5 Murphy Farm _____
Empire Company _____

NORTH

WEST

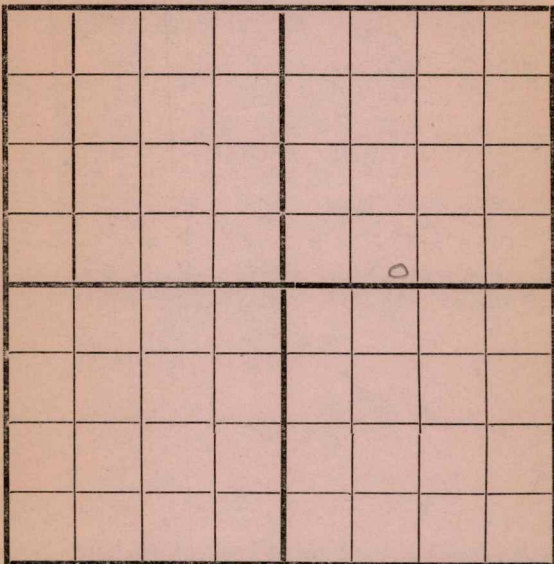

EAST

SOUTH

Location _____
Rig Up _____
Drilling and remarks _____

RECORD

Cased _____ in. _____ Ft.
Sand _____
Gas _____
Oil _____
Total Depth _____

PRODUCTION

1st 24 hrs. Nat. _____
1st 24 hrs. after shot _____
Gas _____ Cu. Ft.
Dry Hole _____
Abandoned _____

Date

12/28 6 1916 Cordiff Scout

Map No. _____ Sec. 31 Twp. 25 R. 5
Well No. 31 4 Murphy Farm
Engine Company
NORTH

WEST

EAST

SOUTH

0

Location _____
Rig Up _____
Drilling and remarks _____

Shut Down
1560'

RECORD

Cased _____ in. _____ Ft.
 Sand _____
 Gas _____
 Oil _____
 Total Depth _____

PRODUCTION

1st 24 hrs. Nat. _____
 1st 24 hrs. after shot _____
 Gas _____ Cu. Ft. _____
 Dry Hole _____
 Abandoned _____


Date _____

Date 1/1, 1917. Condy Scout

Map No. _____ Sec. 31 Twp. 25 R. 5
 Well No. 31 Murphy Farm _____
 _____ Company

NORTH

WEST

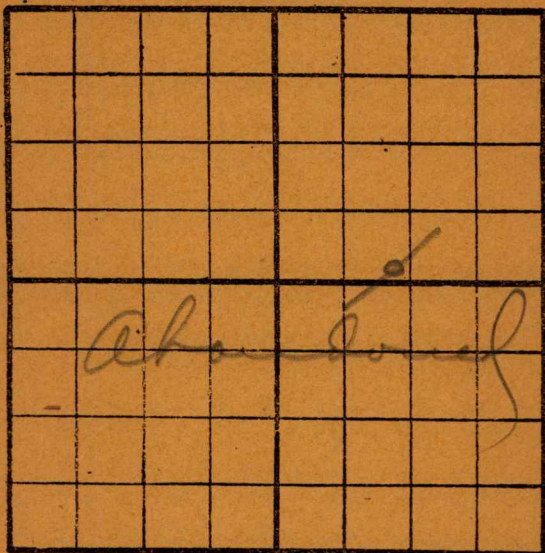

EAST

SOUTH

Location _____

Rig up _____

Drilling and remarks:

*Abandoned
at 1560*

RECORD

Cased _____ in. _____ Ft.

Sand _____

Gas _____

Oil _____

Total Depth _____

PRODUCTION

1st. 24 hrs. Nat. _____

1st. 24 hrs. after shot. _____

Gas _____ Cu. Ft.

Dry Hole _____

Abandoned _____

Date

1/8, 1917, Cond Scout