

Section 1 Township 26 Range 3EWell No. 6 AllanCompany Rex & Morris

Misc.		NORTH					
WEST							
		SOUTH					
EAST							



Sec. 1 Twp. 26 R. 3E

Well No. #6 Allen Farm

Rex & Morris Company


Miscellaneous

990 Ft. from N. Line

 Ft. from S. Line

 Ft. from E. Line

990 Ft. from W. Line

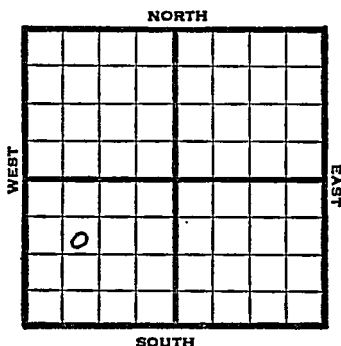

SE NW SW

1947	Elev. 1306' REPORT
7/23	Machine.
7/30	"
8/6	15" @ 141' Drlg 675'
8/13	13" @ 1172' Drlg. 1475'
8/20	10" @ 1760' Drlg 2130'
8/27	8" @ 2225' 7" @ 2385' Drlg. 2480'
9/3	Miss. 2718' TD 2760'
	ABANDONED

Kansas

Map No. _____ Sec. 1 Twp. 26 R. 3EWell No. 6 AllanRex & Morris Company

FIRST REPORT

Contractor

SE NW SW

SECTION PLAT

o			

990 Ft. from N. Line

_____ Ft. from S. Line

_____ Ft. from E. Line

990 Ft. from W. Line

Butler County

Location _____

Rig up _____

Drilling and Remarks:

Machine _____

RECORD

Cased _____ in., _____ ft.

Sand _____

Gas _____

Oil _____

Total Depth _____

PRODUCTION

1st 24 hrs. Nat. _____

1st 24 hrs. after shot _____

Gas _____ Cu. Ft.

Dry Hole _____

Abandoned _____

Date

JUL 23 1947


19

S. J. LEWIS Scout

Map No. 13 Sec. 1 Twp. 26 R. 3EWell No. 6 AllanRex & Morris CompanyABANDONED

Contractor

SE NW SW

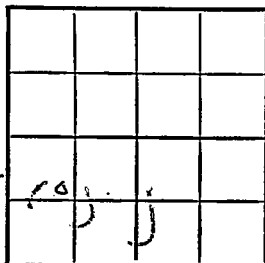E 11306
SECTION PLAT990 Ft. from N. Line Ft. from S. Line Ft. from E. Line990 Ft. from W. LineButler CountyLocation Rig up

Drilling and Remarks:

Mar 27 18

RECORD

Cased in., ft.Sand Gas Oil Total Depth 2760

PRODUCTION

1st 24 hrs. Nat. 1st 24 hrs. after shot Gas Cu. Ft.Dry Hole Abandoned

Date

SEP 3 1947 19 S. J. LEWIS Scout