

Section 2 Township 26 Range 3 EWell No. # 1 HaworthCompany Cox & Burns

NORTH

					0		

WEST

EAST


SOUTH

Butler

KANSAS

Sec. 2 Twp. 26 R. 3EWell No. #1 Haworth FarmCox & Burns CompanyCox & Burns Contractor330 Ft. from N. Line Ft. from S. Line Ft. from E. Line990 Ft. from W. Line

NE NW NE

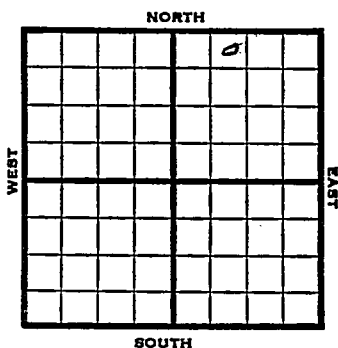

1953

Elev. 1305'

REPORT

6/17

Spud 6-8-53

16" @ 75'

Drlg 800'

7/15

Spud 6-8-53

D&A

TD 2743

16" @ 75'

13" @ 905'

10" @ 1500'

8" @ 2090'

6" @ 2500'

Lans 1945, KC 2245, B KC 2405, Miss 2705'

TD 2743

D&A

ABANDONED


J. G. McGEHEE

County Butler State Kansas
 Sec. 2 (Blk. 26) (Sur. 3 E) Map No.

Operator Cox & Burns

Well No. 1 Farm Haworth

Elev. 1305 Location NE NW NE

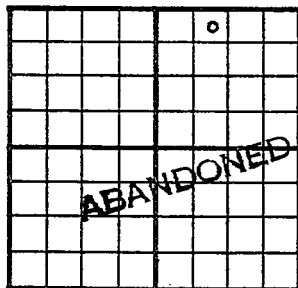

330 Ft. From N Line NE

990 Ft. From W Line Quarter

1st. Report

Completion JUL 15 1953

Remarks

Cox & Burns - Contr.

Spudding Date 6-8-53

Drlg. Data D & A TD 2743

16" @ 75 13" @ 905 10" @ 1500

8" @ 2090 6" @ 2500 Lans. 1945

KC 2245 B KC 2405 Miss. 2705

TD 2743

D & A