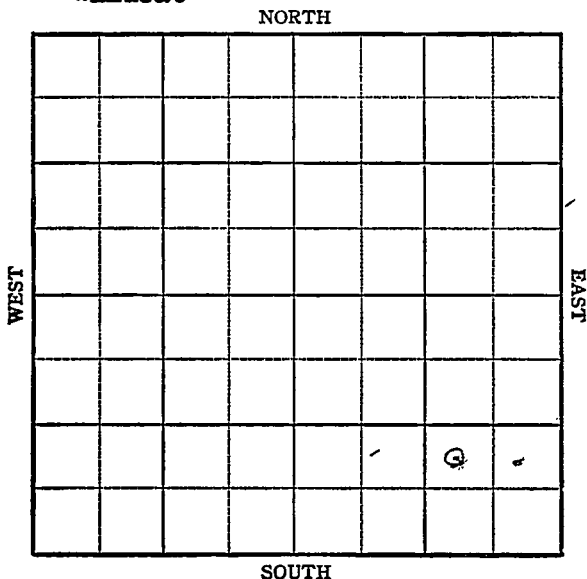


Section 3 Township 26 Range 3-EWell No. #1 Tarsely *(Parsley)*Company Rex & Morris
Wildcat

KANSAS


Butler

Sec. 3 Twp. 26 R. 3E ✓Well No. #1 Tarsely FarmRex & Morris Company

Wildcat

 Ft. from N. Line990' Ft. from S. Line990' Ft. from E. Line Ft. from W. Line

NW SE SE

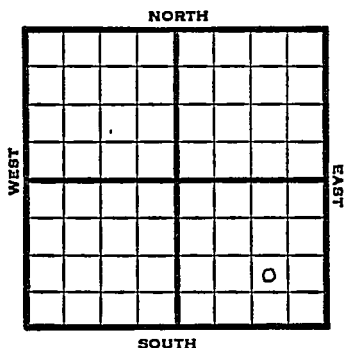


1948	Elev. 1288'	REPORT
12/1	Location	
12/6	Drlg. 135'	
12/14	15" @ 130' Drlg. 920'	
12/22	Drlg. 1635'	
12/29	8" @ 1800' Lansing. 1955' Drlg. 2210'	
1/5	6" @ 2330' Drlg. 2585'	
1/12	KC 2235 Mississippi 2695 5" @ 2694 TD 2704 1500' oil 2 hrs.	
1/19	"	
1/26	Miss 2695' 5" @ 2694' Pump 45 oil Pot. TD 2714' Gr. 38° COMPLETED	

Map No. _____ Sec. 3 Twp. 26 R. 3EWell No. 1 Tarsely_____Rex & Morris_____
Company_____FIRST REPORT_____
Contractor

NW SE SE

SECTION PLAT

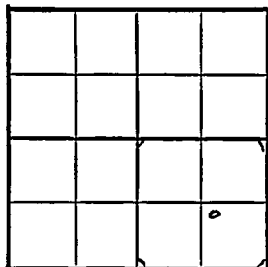_____Ft. from N. Line990 Ft. from S. Line990 Ft. from E. Line_____Ft. from W. LineButler CountyLocation X

Rig up _____

Drilling and Remarks: _____

RECORD

Cased _____ in., _____ ft.

Sand _____

Gas _____

Oil _____

Total Depth _____

PRODUCTION

1st 24 hrs. Nat. _____

1st 24 hrs. after shot _____

Gas _____ Cu. Ft.

Dry Hole _____

Abandoned _____

Date

DEC 1 194819S. I. LEWIS Scout

Map No. 13 Sec. 3 Twp. 26 R. 3E

Well No. 1 Parsley

Rex & Morris Company

COMPLETE

Contractor

NW SE SE


E1, 1288
SECTION PLAT

 Ft. from N. Line

990 Ft. from S. Line

990 Ft. from E. Line

 Ft. from W. Line

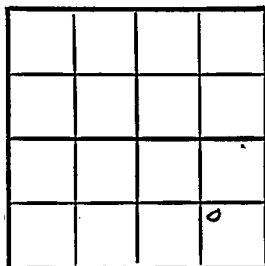

Butler County

Location

Rig up

Drilling and Remarks:

Misc 2695
5" @ 2694
Pump 45 oil Rod

282 Se

RECORD

Cased in., ft.

Sand

Gas

Oil ✓

Total Depth 2714

PRODUCTION

1st 24 hrs. Nat.

1st 24 hrs. after shot

Gas Cu. Ft.

Dry Hole

Abandoned

Date

JAN 26 1949 19 S. I. LEWIS Scout