


Map No. _____ Sec. 7 Twp. 26 R. 35Well No. 6 - Opperman FarmSouthwestern Company

NORTH

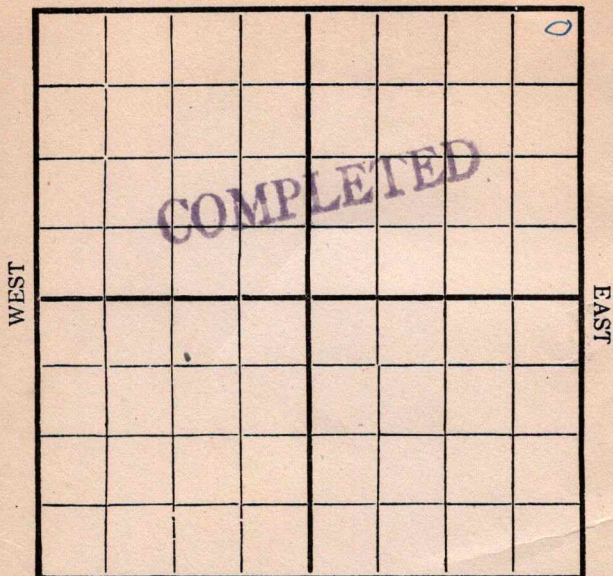

SOUTH

Location _____

Rig Up _____

Drilling Remarks:

Drilling Remarks:

RECORD

Cased _____ in _____ Ft.

Sand _____

Gas _____

Oil _____

Total Depth _____

PRODUCTION

1st 24 hrs. Nat. _____

1st 24 hrs. after shot _____

Gas _____ Cu. Ft.

Dry Hole _____

Abandoned _____

Map No. K14 Sec. 7 Twp. 26 R. 5
 Well No. 6.0 of section Farm
Southern Company

NORTH

WEST

EAST

SOUTH

Location ✓
 Rig Up ✓
 Drilling and remarks

RECORD

Cased in. Ft.
 Sand
 Gas
 Oil
 Total Depth

PRODUCTION

1st 24 hrs. Nat.
 1st 24 hrs. after shot
 Gas Cu. Ft.
 Dry Hole
 Abandoned

Date

191

Scout

Map No. _____ Sec. 7 Twp. 26 R. 5
Well No. 6 Opferman Farm
Painte Western Company

NORTH

WEST

EAST

SOUTH

Location _____
Rig Up ☒ _____
Drilling and remarks _____

RECORD

Cased _____ in. _____ Ft.
Sand _____
Gas _____
Oil _____
Total Depth _____


PRODUCTION

1st 24 hrs. Nat. _____
First 24 hrs. after shot _____
Gas _____ Cu. Ft.
Dry Hole _____
Abandoned _____

Date

2/5, 1917 2 Condy Scout

Map No. _____ Sec. 17 Twp. 26 R. 5
Well No. 6 Opf. Sec. 17 Farm _____
South Western Company

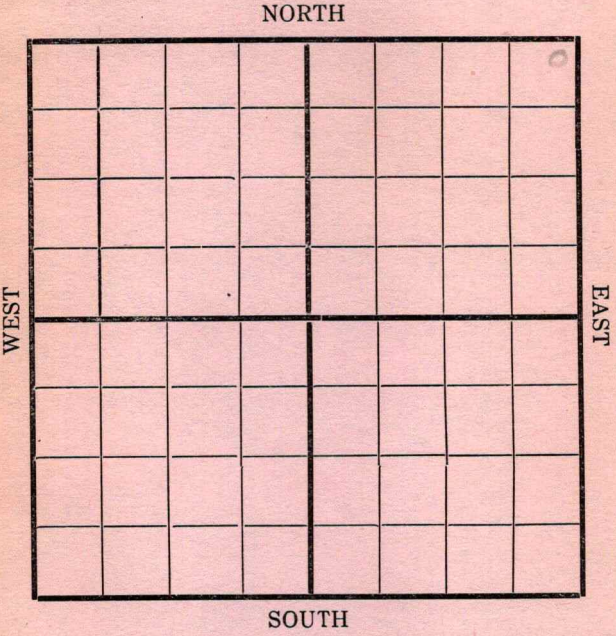

Location _____ Rig Up _____ Drilling and remarks 130'	RECORD Cased _____ in. _____ Ft. Sand _____ Gas _____ Oil _____ Total Depth _____ PRODUCTION 1st 24 hrs. Nat. _____ 1st 24 hrs. after shot _____ Gas _____ Cu. Ft. Dry Hole _____ Abandoned _____
---	---

Date 2/12/1917 Scout Ed. Jeff

Date 2/19, 1917. Candice Scout

Map No. _____ Sec. 7 Twp. 26 R. 5Well No. 6 of Spencer FarmSouthwestern Company

NORTH

WEST

EAST

SOUTH

Location _____

Rig Up _____

Drilling and remarks

1500

RECORD

Cased _____ in. _____ Ft.

Sand _____

Gas _____

Oil _____

Total Depth _____

PRODUCTION

1st 24 hrs. Nat. _____

First 24 hrs. after shot _____

Gas _____ Cu. Ft.

Dry Hole _____


Abandoned _____

Date

Feb 7 191 Cardiff Scout

Map No. _____ Sec. 7 Twp. 26 R. 5
Well No. 6 Opfermann Farm
Southwestern Company

NORTH

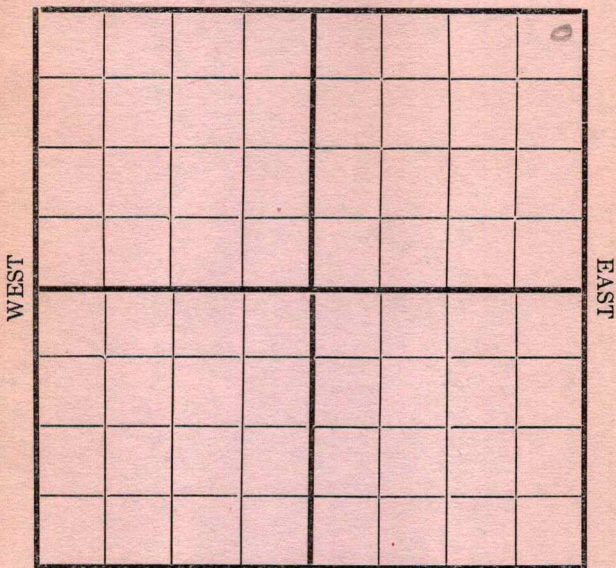

SOUTH

Location _____

Rig Up _____

Drilling and remarks

2360'

RECORD

Cased _____ in. _____ Ft.

Sand _____

Gas _____

Oil _____

Total Depth _____

PRODUCTION

1st 24 hrs. Nat. _____

1st 24 hrs. after shot _____

Gas _____ Cu. Ft.

Dry Hole _____

Abandoned _____

Date


3-5-7, 1917 Condy Scout

Map No. Sec. 7 Twp. 26 R. 5Well No. 6 Opperman FarmSouth Western Company

NORTH

WEST

EAST

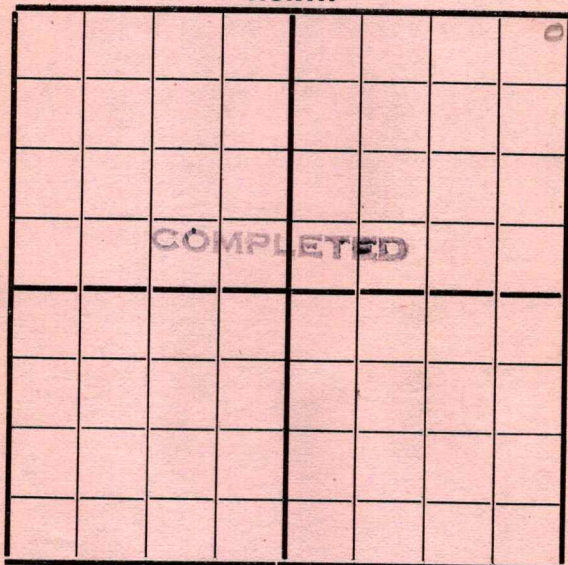

SOUTH

Location

Rig up

Drilling and Remarks:

COMPLETED

Est at 100
Bbl

RECORD

Cased in. Ft.

Sand 2430-2445

Gas

Oil

Total Depth

PRODUCTION

1st 24 hrs. Nat.

1st 24 hrs. after shot

Gas Cu. Ft.

Dry Hole

Abandoned

Date

3/12, 1917, Carley Scout