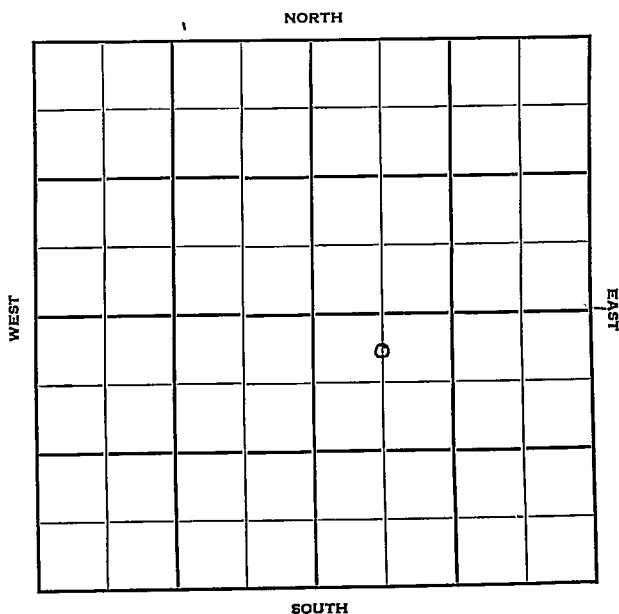


FORM 51 25M 3-49 PETROL

KANSAS

Section 2 Township 26 Range 3-EWell No. #1 MervilleCompany Bennett & Able

Butler

KANSAS

Sec. 2 Twp. 26 R. 3E ✓

Well No. #1 Merville Farm

Bennett & Able Company

Contractor


330' Ft. from N. Line

_____ Ft. from S. Line

_____ Ft. from E. Line

660' Ft. from W. Line

C N/2 NW SE

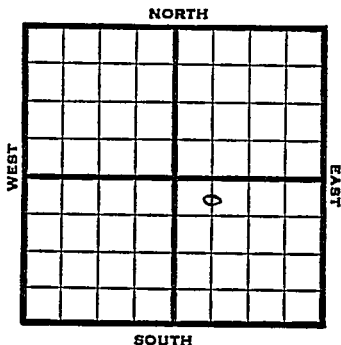

1950

Elev 1282

REPORT

5/31

Rig up

7/12

20" @ 29

13" @ 820

10" @ 1225

8" @ 1784

Lans 1940

7" @ 2345

Miss 2700-05

TD 2735

HFW

D&A

KC 2235

ABANDONED

Map No. _____ Sec. 2 Twp. 26 R. 3EWell No. 1 MervilleBennett & Able Company_____
Contractor

C N/2 NW SE

SECTION PLAT

330 Ft. from N. Line

_____ Ft. from S. Line

_____ Ft. from E. Line

660 Ft. from W. Line

		o	
FIRST	REPORT		

Butler

Location _____

Rig up X

Drilling and Remarks:

RECORD

Cased _____ in., _____ ft.

Sand _____

Gas _____

Oil _____

Total Depth _____

PRODUCTION

1st 24 hrs. Nat. _____

1st 24 hrs. after shot _____

Gas _____ Cu. Ft.

Dry Hole _____

Abandoned _____

Date

MAY 3 1950

J. E. TYRA Scout

Kansas

Map No. _____ Sec. 2 Twp. 26 R. 3EWell No. 1 Merville

_____ Bennett & Abel _____ Company


_____ Contractor

C N L NW SE

El. 1282
SECTION PLAT330 Ft. from N. Line

_____ Ft. from S. Line

_____ Ft. from E. Line

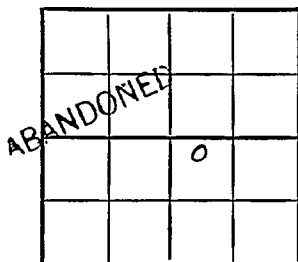660 Ft. from W. Line

Butler County

Location _____

Rig up _____

Drilling and Remarks:

20" C 29

13" C 820

10" C 1225

8" C 1784

Lans. 1940

KC 2235

7" C 2345

RECORD

Cased _____ in., _____ ft.

Sand _____

Gas _____

Oil _____

Total Depth 2735

PRODUCTION

1st 24 hrs. Nat. _____

1st 24 hrs. after shot _____

Gas _____ Cu. Ft.

Dry Hole _____

Abandoned _____

Date

JUL 12 1950 19J. E. TYRA Scout

Miss. 2700-05

TD 2735

HFW

D & A

JUL 21 1950

Scout Cards
Land Small Map
Land Wall Map
Tracings
France Map
Pierce Map
Misc.

D IN 1950

BIR

TO

RECORD













