FORM 51 10M 2-49 PETROL


KANSAS Butler

Section 3 Township 26 Range 3E

Well No. 3 Parsley

Company Rex & Morris

Misc.

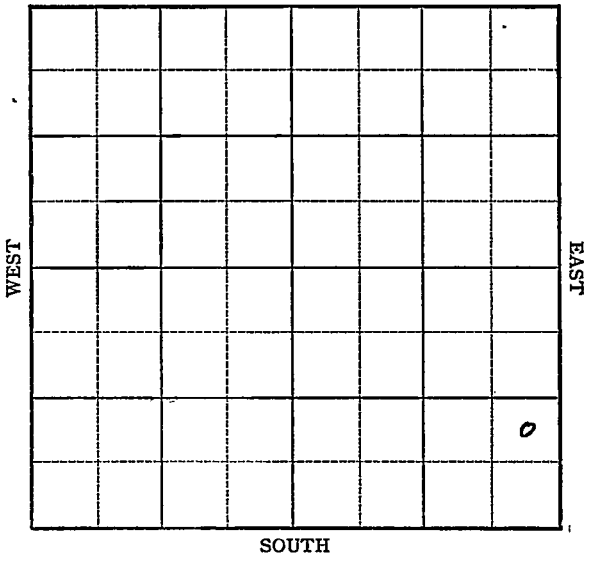

FORM 252-A
5M 10-48 PETROL

KANSAS Butler

Sec. 3 Twp. 26 R. 3E

Well No. #3 Parsley Farm

Rex & Morris Company

Miscellaneous


_____ Ft. from N. Line

990' Ft. from S. Line

330' Ft. from E. Line

_____ Ft. from W. Line

NE SE SE

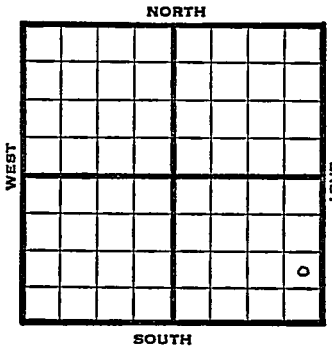

1303'
1949 Elev 1300' REPORT

3/9 Machine

3/16 15" @ 110'
Drlg. 310'

3/23 13"@ 925'
Drlg 1005'

3/30 10"@ 1190'
8" @ 1800'

4/6 Drlg. 2395'

4/12 Miss 2481'
TD 2488'
5" @ 2481'

4/20 TD 2739'
Miss 2481'
5"@ 2481'
Pump 40 Oil Pot
38° Gr.
Comp

COMPLETED

Form 26 200 Bks. 9-48 Petrol

Kansas

Miscellaneous

Map No. _____ Sec. 3 Twp. 26 R. 3E

Well No. 3 Parsley


Rex & Morris Company

FIRST REPORT

Contractor

NE SE SE

SECTION PLAT

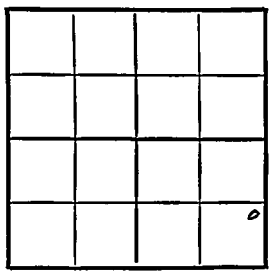

_____ Ft. from N. Line

990 Ft. from S. Line

330 Ft. from E. Line

_____ Ft. from W. Line

Butler County

Location _____

Rig up _____

Drilling and Remarks:

Machine

RECORD

Cased _____ in., _____ ft.

Sand _____

Gas _____

Oil _____

Total Depth _____

PRODUCTION

1st 24 hrs. Nat. _____

1st 24 hrs. after shot _____

Gas _____ Cu. Ft.

Dry Hole _____

Abandoned _____

Date

MAR 9 1949 19 S. J. LEWIS Scout

Form 26 200 Bks. 9-48 Petrol

Miscellaneous

Kansas

Map No. K13 Sec. 3 Twp. 26 R. 3E

Well No. 3 Parsley


Rex & Morris Company

COMPLETE Contractor

NE SE SE

E 1,1303

SECTION PLAT

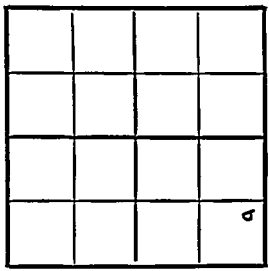

Ft. from N. Line

990 Ft. from S. Line

330 Ft. from E. Line

Ft. from W. Line

Butler County

Location

Rig up

Drilling and Remarks:

Rtd 2487

5" @ 2487

Pump 400 bbl RX

385 bbl

RECORD

Cased in., ft.

Sand

Gas

Oil

Total Depth 2799

PRODUCTION

1st 24 hrs. Nat.

1st 24 hrs. after shot

Gas Cu. Ft.

Dry Hole

Abandoned

Date

APR 20 1949 19

S. J. LEWIS Scout