


Map No. _____ Sec. 7 Twp. 26 R. 5
 Well No. 12 Opperman Farm
S.W. 8 Carter Company

NORTH

WEST

EAST

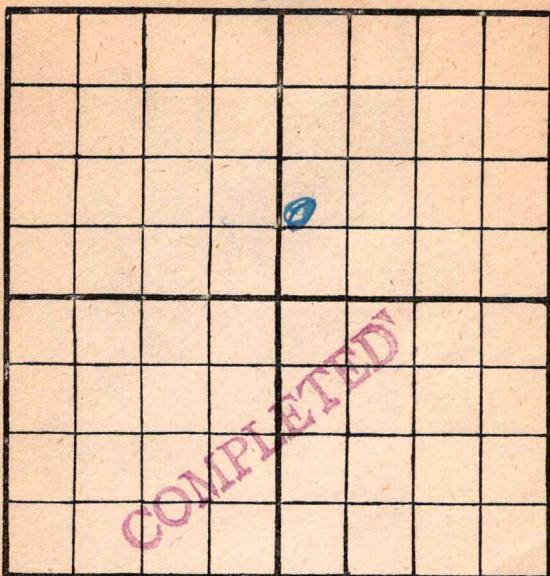

SOUTH

Location _____

Rig Up _____

Drilling Remarks:

Drilling Remarks:

RECORD

Cased _____ in. _____ ft.

Sand _____

Gas _____

Oil _____

Total Depth _____

PRODUCTION

1st 24 hrs. Nat. _____

1st 24 hrs. after shot _____

Gas _____ cu. ft


Dry Hole _____

Abandoned _____

100# K14
 Map No. _____ Sec. 7 Twp. 26 R. 5
 Well No. 12 Opperman Farm _____
D H & Carter Company _____

NORTH

WEST

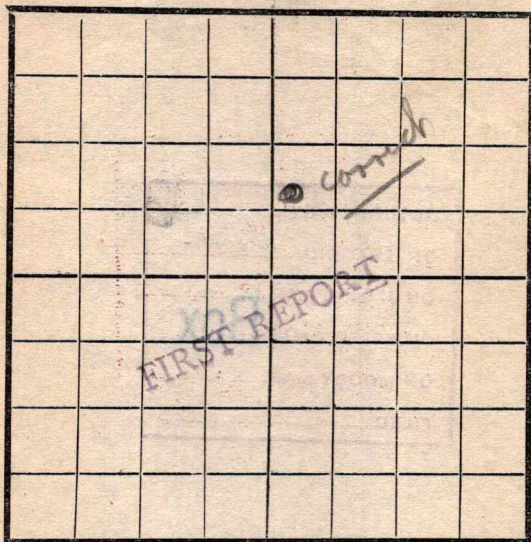

EAST

SOUTH

Location _____
 Rig Up ☒ _____
 Drilling and remarks _____

RECORD

Cased _____ in. _____ Ft.
 Sand _____
 Gas _____
 Oil _____
 Total Depth _____

PRODUCTION

1st 24 hrs. Nat. _____
 1st 24 hrs. after shot _____
 Gas _____ Cu. Ft.
 Dry Hole _____
 Abandoned _____

Date

3/11, 1918 Dyke Scout _____

Map No. _____ Sec. 7 Twp. 26 R. 5Well No. 12 Opperman FarmD. H. & Carter Company

NORTH

WEST

EAST

SOUTH

Location _____

Rig Up _____

Drilling and remarks

RECORD

Cased _____ in. _____ Ft.

Sand _____

Gas _____

Oil _____

Total Depth _____

PRODUCTION

1st 24 hrs. Nat. _____

1st 24 hrs. after shot _____

Gas _____ Cu. Ft.

Dry Hole _____

Abandoned _____

Date

191

Scout

Map No. _____ Sec. 7 Twp. 26 R. 5Well No. 12 Opperman FarmCarter S. St. Company

NORTH

WEST

EAST

SOUTH

Location _____

Rig Up _____

Drilling and remarks

1430'

RECORD

Cased _____ in. _____ Ft.

Sand _____

Gas _____

Oil _____

Total Depth _____

PRODUCTION

1st 24 hrs. Nat. _____

1st 24 hrs. after shot _____

Gas _____ Cu. Ft.

Dry Hole _____

Abandoned _____

Date


4/10, 1918Dyke Scout

Map No. _____ Sec. 7 Twp. 26 R. 5
 Well No. 12 Opperman Farm
Carter S. H. Company

NORTH

WEST

EAST

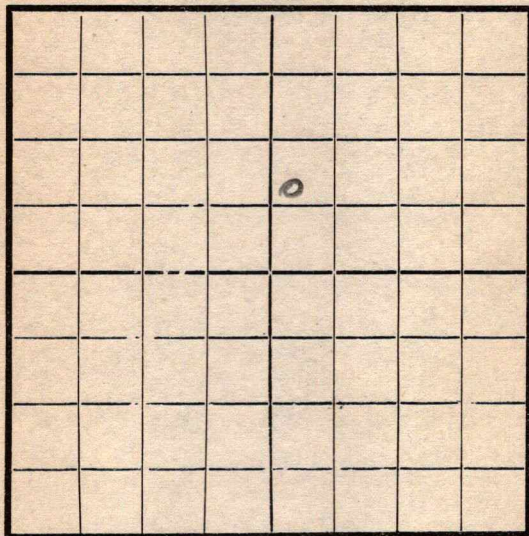

SOUTH

Location _____
 Rig Up _____
 Drilling and remarks

1900'

RECORD

Cased _____ in. _____ Ft.
 Sand _____
 Gas _____
 Oil _____
 Total Depth _____


PRODUCTION

1st 24 hrs. Nat. _____
 1st 24 hrs. after shot _____
 Gas _____ Cu. Ft.
 Dry Hole _____
 Abandoned _____

Date 4/8, 1918 Cy a Scout
17

Map No. _____ Sec. 7 Twp. 26 R. 5
 Well No. 12 Opperman Farm _____
Carter D H. Company _____

NORTH

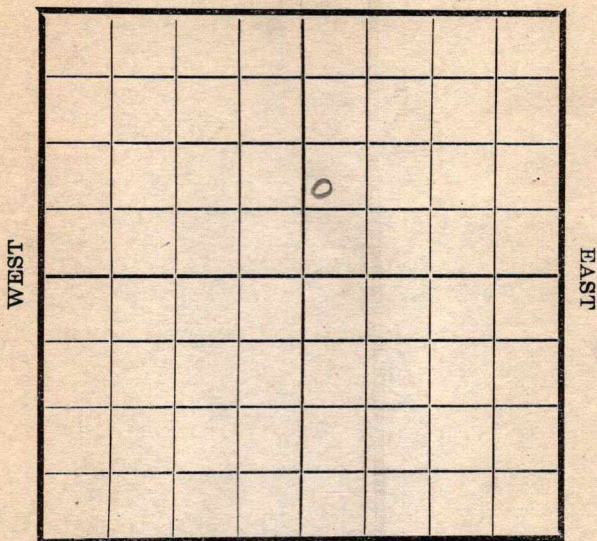

SOUTH

Location _____

Rig Up _____

Drilling and remarks

RECORD

Cased _____ in. _____ Ft.

Sand _____

Gas _____

Oil _____

Total Depth _____

PRODUCTION

1st 24 hrs. Nat. _____

1st 24 hrs. after shot _____

Gas _____ Cu. Ft.

Dry Hole _____

Abandoned _____

Date

4/23, 1918 Cy h _____ Scout _____

Map No. K14 Sec. 7 Twp. 26 R. 5Well No. 12 OppermanCarter Oil Company

Contractor

NORTH

WEST

EAST

COMPLETED

SOUTH

Location _____

Rig up _____

Drilling and Remarks:

RECORD

Cased _____ in., _____ ft.

Sand 2426-2513

Gas _____

Oil _____

Total Depth _____

PRODUCTION

1st 24 hrs. Nat. 60 bbls

1st 24 hrs. after shot _____

Gas _____ Cu. Ft.

Dry Hole _____

Abandoned _____

Date

7/4 1918

Scout