FORM 51 10M 7-48 PETROL


KANSAS Butler

Section 7 Township 26 Range 5E

Well No. 23 Hull-Higgins

Company Cities Service

Misc.

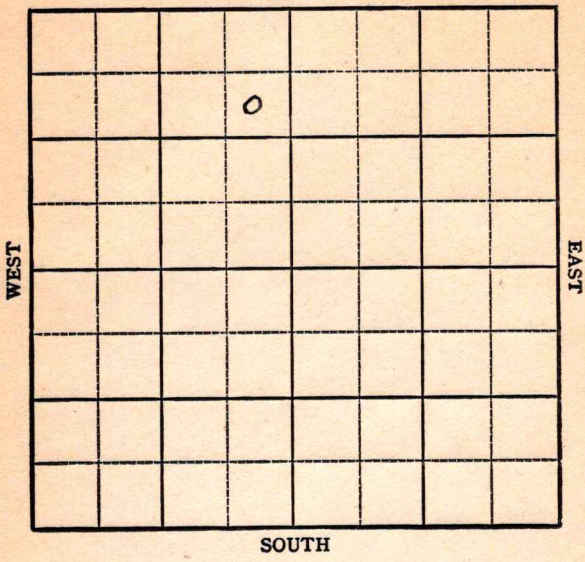

FORM 252-A
5M 10-48 PETROL

KANSAS Butler

Sec. 7 Twp. 26 R. 5E ✓

Well No. #23 Hull - Higgins Farm

Cities Service Company

Miscellaneous


990' Ft. from N. Line

_____ Ft. from S. Line

330' Ft. from E. Line

_____ Ft. from W. Line

SE NE NW

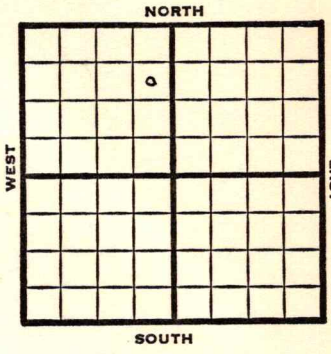

1948	Elev 1379' REPORT
12/8	Location
12/14	8" @ 74'
12/22	Lansing 1668' KC 1972' Arbuckle 2421' Drlg. 2425'
12/29	"
1/5	TD 2425' 5" @ 2423'
1/12	"
1/19	"
1/26	TD 2459
2/2	20 qts to fsg. "
2/9	TD 2459' Arb. 2421' 5"@ 2423' Pump 110 Oil Pot 380 Wtr. Comp

COMPLETED

Form 26 200 Bks. 9-48 Petrol

Kansas

Miscellaneous

Map No. _____ Sec. 7 Twp. 26 R. 5E

Well No. 23 Hull - Higgins


Cities Service Company

FIRST REPORT

Contractor

SE NE NW

SECTION PLAT

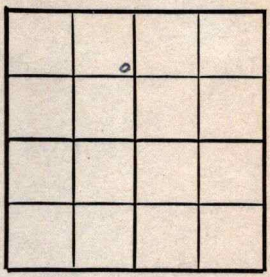

990 Ft. from N. Line

_____ Ft. from S. Line

330 Ft. from E. Line

_____ Ft. from W. Line

Butler County

Location x

Rig up _____

Drilling and Remarks:

RECORD

Cased _____ in., _____ ft.

Sand _____

Gas _____

Oil _____

Total Depth _____

PRODUCTION

1st 24 hrs. Nat. _____

1st 24 hrs. after shot _____

Gas _____ Cu. Ft.

Dry Hole _____

Abandoned _____

Date

DEC 8 1948 19

S. J. LEWIS Scout

Form 26 200 Bks. 9-48 Petrol

Kansas

Miscellaneous

Map No. K14 Sec. 7 Twp. 26 R. 5E

Well No. 23 Hull-Higgins

Cities Service Company


COMPLETE

Contractor

SE NE NW

El. 1899

SECTION PLAT

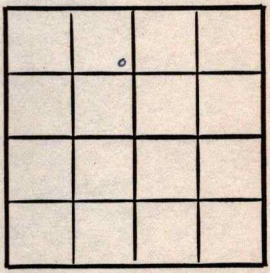

990 Ft. from N. Line

Ft. from S. Line

990 Ft. from E. Line

Ft. from W. Line

Butler

Location

Rig up

Drilling and Remarks:

Cm 2421

5" @ 2423

Pump 110 oil BO

38° Gr

RECORD

Cased in., ft.

Sand

Gas

Oil

Total Depth 2459

PRODUCTION

1st 24 hrs. Nat.

1st 24 hrs. after shot

Gas Cu. Ft.

Dry Hole

Abandoned

Date

FEB 9 1949 19

S. J. LEWIS Scout