
FORM 51 25M 8-50 WESTERN Butler KANSAS

Section 7 Township 26 Range 5 E

Well No. # 26 Hull-Higgins

Company Cities Service Oil

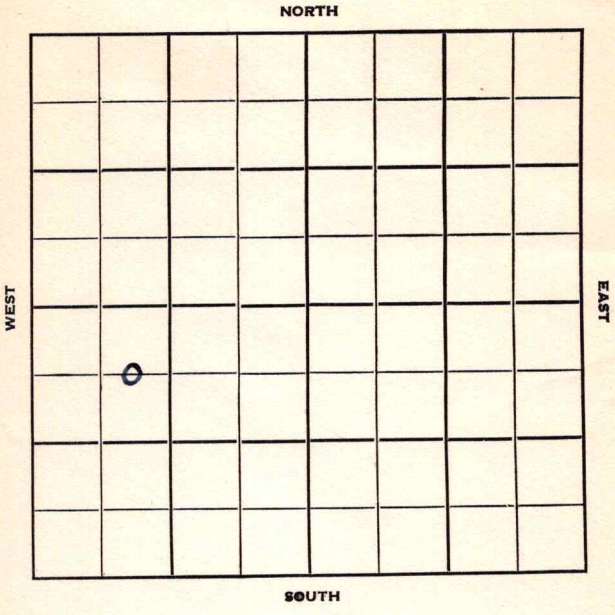

FORM 252-B
10M 8-51 TPCO.

Butler

KANSAS

Sec. 7 Twp. 26 R. 5E

Well No. #26 Hull - Higgins Farm

Cities Service Oil Company

Contractor


660 Ft. from N. Line

Ft. from S. Line

Ft. from E. Line

990 Ft. from W. Line

CEL NW SW

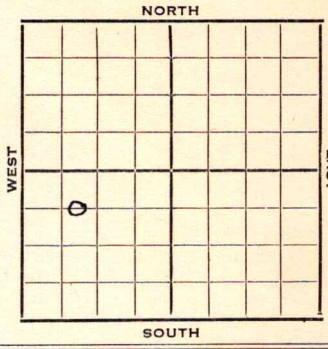

1952	Elev. 1364' REPORT
5/28	10" @ 88' Arb. 2414 RTD 2417' 7" @ 2415' WOC
6/11	Oil Well TD 2457' 10" @ 88 Arb. 2414 TD 2417 7" @ 2415' DD 2457 35 qt/ 2431-57 Comp. 86 bopd 133 bw

COMPLETED

FORM 275 FOR SALE BY KANSAS BLUE PRINT CO.


County Butler State Kansas

Sec. 7 (Blk. Twp.) 26 (Sur. Rge.) 5E Map No.

Operator Cities Service Oil

Well No. 26 Farm Hull - Higgins

Elev. 1364 Location CEL NW SW

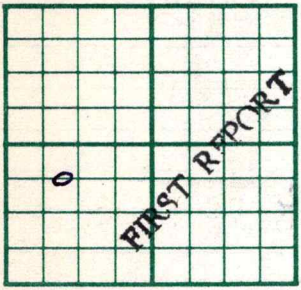

660 Ft. From N Line SW

990 Ft. From W Line Quarte

1st. Report MAY ? 8 1952

Completion

Remarks

Spudding Date

Drlg. Data

10" @ 88 Arb 2414 RTD 2417 7" @ 2415 WOC

J. G. McGEHEE

FORM 275 FOR SALE BY KANSAS BLUE PRINT CO

County Butler State Kansas

Sec. 7 (Blk. Twp.) 26 (Sur. Rge.) 5E Map No.

Operator Cities Service

Well No. 26 Farm Hull - Higgins

Elev. 1364 Location C E L NW SW



660 Ft. From N Line SW

990 Ft. From W Line Quarte

1st. Report

Completion JUN 11 1952

Remarks

Spudding Date

Drlg. Data Oil well TD 2457

10" @ 88 Arb. 2414 TD 2417 7" @ 2415

DD 2457 35 qt/ 2431-57

Comp. 86 bopd 133 bw

J. G. McGEHEE