KANSAS Sedgwick


FORM 51 5M 4-41 PETROL

O.W.W.O.

Section 33 Township 26 Range 2-E

Well No. #2 JENSEN ~~#1 Gesell~~

Company W.L. HART MAN ~~T. W. Murfin et al~~

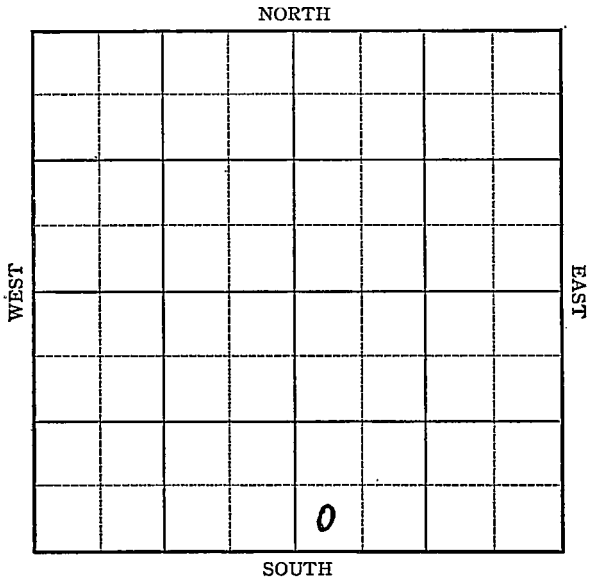

FORM 252-A, 5M 6-41 PETROL KANSAS Sedgwick ✓

O.W.W.O.

Sec. 33 Twp. 26 R. 2-E

Well No. ~~#1 Gesell~~ #2 JENSEN Farm

~~W. L. HARTMAN~~ ~~I. W. Murfine et al~~ Company

(Greenwich)

_____ Ft. from N. Line


330 Ft. from S. Line

_____ Ft. from E. Line

330 Ft. from W. Line

SW SW SE

Elev. 1390

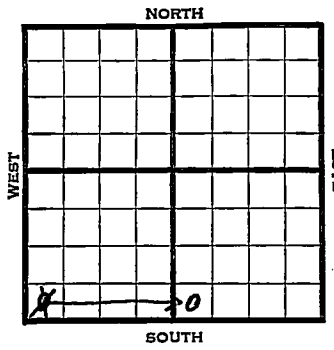

1941	REPORT
9/24	Machine.
10/2	15" - 110' Drlg. 420'
10/9	Drlg. 1120'
10/16	Topeka 1550' Drlg. 1560'
10/23	Lams. 2125'
	TD 2225' SD.
10/30	" "
11/6	" "
11/13	" "
11/20	10" - 2242' T.D. 2305'
	U.R. 10".
11/28	10" - 2270' K.C. 2478'
	T.D. 2592' Run 8".
12/4	8" - 2592' Miss. 2923'
	7" - 2924' Drlg. 2965'
12/11	~~Meisner 3239~~ Viola 3240
	TD 3261 S.O.
2/18	" " "
	OVER

1941
12/23 Simpson 3272'
5" - 3356'
T.D. 3362'
H.F.W.

ABANDONED

O.W.W.O.

1952
7/9 Location
12/17 Spud 7-14-52
8" @ 70
5" @ 3247
OTD 3362
CO to 3356
D&A

ABANDONED

Form 26 200 Bks. 5-41 McW. Sedgwick KANSAS

Map No. _____ Sec. 33 Twp. 26 R. 2E

Well No. 1 Gesell

I. W. Murfine etal Company

FIRST REPORT Contractor

SW SE

_____ Ft. from N. Line


330 Ft. from S. Line

_____ Ft. from E. Line

330 Ft. from W. Line

GREENWICH POOL

SECTION PLAT

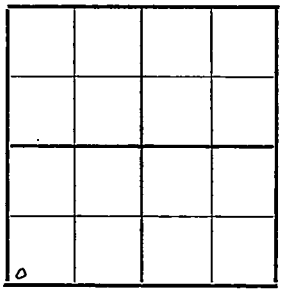

Location _____

Rig up _____

Drilling and Remarks:

Machine

RECORD

Cased _____ in., _____ ft.

Sand _____

Gas _____

Oil _____

Total Depth _____

PRODUCTION

1st 24 hrs. Nat. _____

1st 24 hrs. after shot _____

Gas _____ Cu. Ft.

Dry Hole _____

Abandoned _____

Date

SEP 24 1941 19 S. J. LEWIS Scout

Form 26 20C Bks. 5-41 McW. Sedgwick **KANSAS**

Map No. K-13 Sec. 33 Twp. 26 R. 2E

Well No. 1 Gesell

I. W. Murfin etal Company

CORRECTION Contractor

SW SE

____ Ft. from N. Line


330 Ft. from S. Line

____ Ft. from E. Line

330 Ft. from W. Line

GREENWICH POOL

SECTION PLAT

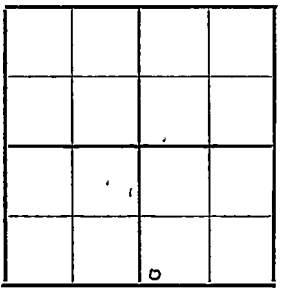

Location ____

Rig up ____

Drilling and Remarks:

Had it spotted wrong

RECORD

Cased ____ in., ____ ft.

Sand ____

Gas ____

Oil ____

Total Depth ____

PRODUCTION

1st 24 hrs. Nat. ____

1st 24 hrs. after shot ____

Gas ____ Cu. Ft.

Dry Hole ____

Abandoned ____

Date

SEP 24 1941 19 S. J. LEWIS Scout

Form 26 200 Bks. 5-41 McW. Sedgwick KANSAS

Map No. 13 Sec. 33 Twp. 26 R. 2E

Well No. 1 Gesell

I. W. Murfine etal. Company

ABANDONED Contractor

SW SE


Ft. from N. Line

330 Ft. from S. Line

Ft. from E. Line

330 Ft. from W. Line

SECTION PLAT

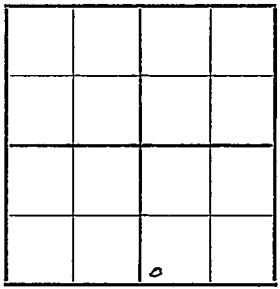

GREENWICH POOL

Location

Rig up

Drilling and Remarks:

Simpson 3272
-C03366

HFW

RECORD

Cased in., ft.

Sand

Gas

Oil

Total Depth 3362

PRODUCTION

1st 24 hrs. Nat.

1st 24 hrs. after shot

Gas Cu. Ft.

Dry Hole

Abandoned

Date

DEC 23 1941 19 S. J. LEWIS Scout

FORM 275 FOR SALE BY KANSAS BLUE PRINT CO.

O.W.W.O.


County Sedgwick State Kansas

Sec. 33 (Blk. Twp.) 26 (Sur. Rge.) 2E Map No.

Operator W. L. Hartman

Well No. 2 Farm Jensen

Elev. 1390 Location SW SW SE

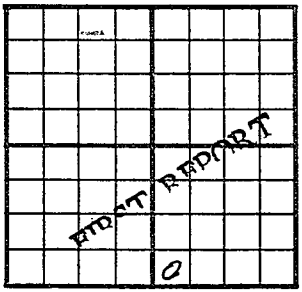

330 Ft. From S Line SE

330 Ft. From W Line Quarter

1st. Report July 9 1952

Completion

Remarks

O.W.W.O.

Spudding Date

Drlg. Data

Location

J. G. McGEHEE

FORM 275 FOR SALE BY KANSAS BLUE PRINT CO

O.W.W.O.


County Sedgwick State Kansas

Sec. 33 (Blk. Twp.) 26 (Sur. Rge.) 2E Map No.

Operator W. L. Hartman

Well No. 2 Farm Jensen

Elev. 1390 Location SW S W SE

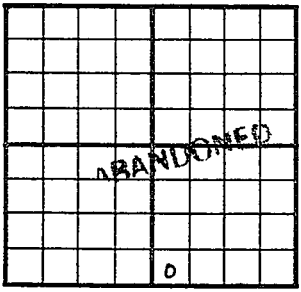

330 Ft. From S Line SE

330 Ft. From W Line Quarter

1st. Report

Completion DEC 17 1952

Remarks OWWO O.W.W.O.

Spudding Date 7-14-52

Drlg. Data

8" @ 70 5" @ 3247 OTD 3362 CO to 3356

D & A

J. G. McGEHEE