
FORM 51 25M 8-50 WESTERN Sedgwick KANSAS

Section 33 Township 26 Range 2 E

Well No. # 1 Luening

Company J. P. Gatty

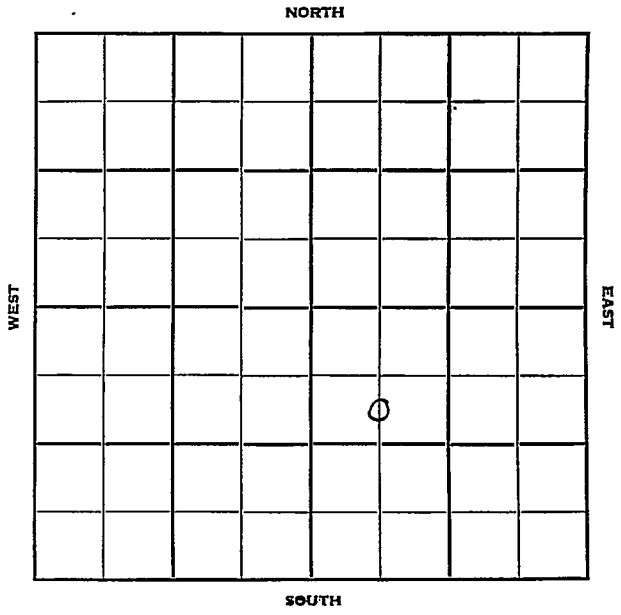

FORM 252-B
10M 11-50 PETROL

Sedgwick KANSAS

Sec. 33 Twp. 26 R. 2E

Well No. #1 Luening Farm

J. P. Gatty Company

Morrison Drlg. - Contr. Contractor

Wildcat


990' Ft. from N. Line

Ft. from S. Line

Ft. from E. Line

660' Ft. from W. Line

C S L NW SE

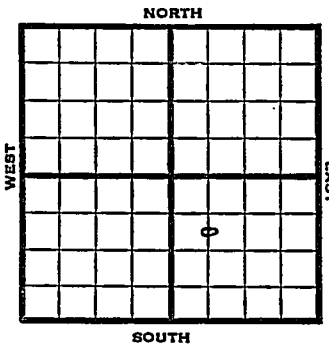

1951	Elev. 1392' REPORT
5/23	RUR
8/1	Oil Well TD 3372 Heeb. 1901 Lans. 2122 KC 2482 Mar 2646 Miss 2946 Kh 3185 Chattanooga 3231 Hunton 3234 Viola 3272 Simp 3278 Simp sd 3282 TD 3360 5" @ 3360 DD 3372 SP 3360½ 12/3352-56 12/3338-42 SP 3350 S/25 bopd Comp.

COMPLETED

FORM 275 FOR SALE BY KANSAS BLUE PRINT CO.


County Sedgwick State Kansas

Sec. 33 (Blk. Twp.) 26 (Sur. Rge.) 2E Map No.

Operator J. P. Getty

Well No. 1 Farm Luening

Elev. Location C S L NW SE

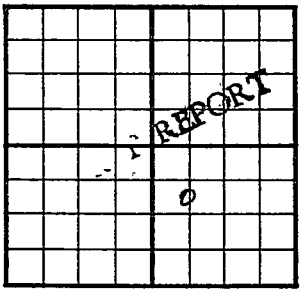

990 Ft. From N Line SE

660 Ft. From W Line Quarter

1st. Report MAY 23 1951

Completion

Remarks

Morrison Drlg. - Contr.

Spudding Date

Drlg. Data Wildcat

R U R

J. E. TYRA

FORM 275 FOR SALE BY KANSAS BLUE PRINT CO.


County Sedgwick State Kansas

Sec. 33 (Blk. Twp.) 26 (Sur. Rge.) 2E Map No.

Operator J. P. Gatty

Well No. 1 Farm Luening

Elev. 1392 Location C S L NW SE

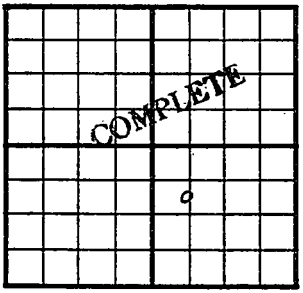

990 Ft. From N Line SE

660 Ft. From W Line Quarter

1st. Report

Completion AUG 1 1951

Remarks Wildcat

Morrison Drlg. - Contr.

Spudding Date

Drlg. Data Oilwell TD 3372

Heeb. 1901 Lans. 2122 KC 2482

Mar. 2646 Miss. 2946 Kh. 3185

Chattanooga 3231 Hunton 3234 Viola 3272

Simp. 3278 Simp. sd. 3282 TD 3360

5" @ 3360 DD 3372 SP 3360½

12/ 3352-56 12/ 3338-42 SP 3350

S/ 25 bopd Comp.

J. E. TYRA