


Section 33 Township 26 Range 2 E

Well No. # 1 Morawitz

Company W. L. Hartman

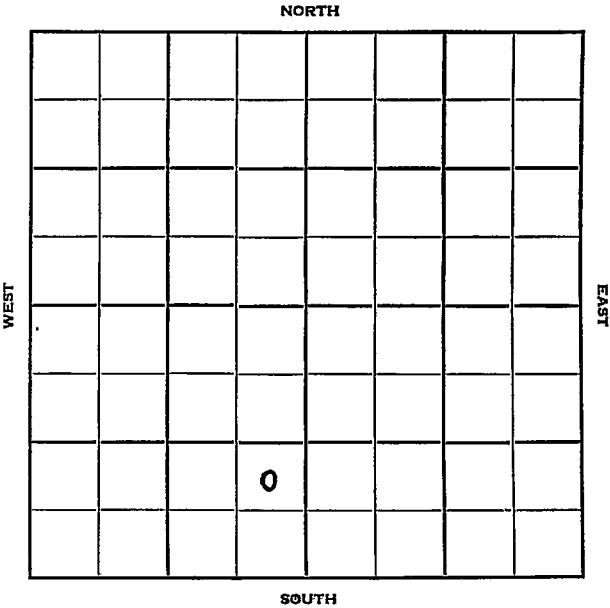

Sedgwick

KANSAS ✓

Sec. 33 Twp. 26 R. 2E

Well No. #1 Morawitz Farm

W.L. Hartman Company

Hartman - Contr. Contractor

 Ft. from N. Line

990'


 Ft. from S. Line

330'

 Ft. from E. Line

 Ft. from W. Line

NE SE SW

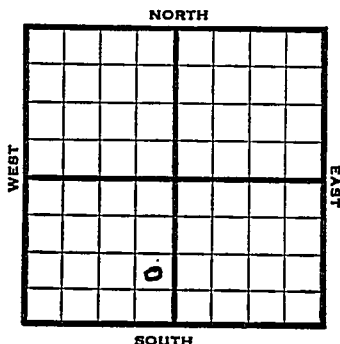

1952

Elev. 1401' REPORT

6/25

Location

7/16

Spud 6-26-52

D&A TD 3394

8" @80'

Heeb. 1927 Lans. 2141

KC 2497 Marm. 2660

Miss 2949 Misener 3265

Maq. 3280 Viola 3290


Simp 3296 Sd 3300

Arb. 3390-94 TD

D&A

ABANDONED

County Sedgwick State Kansas
 Sec. 33 (Bik. Twp.) 26 (Sur. Rge.) 2E Map No. _____
 Operator W. L. Hartman
 Well No. 1 Farm Morawitz
 Elev. _____ Location NE SE SW

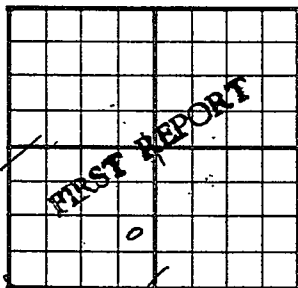

990 Ft. From S Line SW
330 Ft. From E Line Quarter

1st. Report JUN 25 1952

Completion _____

Remarks _____

Hartman - Contr.

Spudding Date _____

Drig. Data _____

Location


J. G. McGEHEE

County Sedgwick State Kansas
 Sec. 33 (Blk. 26 (Sur. 2E Map No.)
 (Twp.) (Rge.)

Operator W. L. Hartman

Well No. 1 Farm Morawitz

Elev. 1401 Location NE SE SW

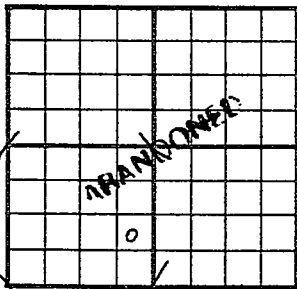

990 Ft. From S Line SW

330 Ft. From E Line Quarter

1st. Report

Completion JUL 16 1952

Remarks

Hartman - Contr.

Spudding Date 6-26-52

Drlg. Data D & A TD 3394

8" @ 80 Heeb. 1927 Lans. 2141

KC 2497 Marm. 2660 Miss. 2949

Misener 3265 Maq. 3280 Viola 3290

Simp. 3296 Sd. 3300 Arb. 3390-94 TD

D & A

J. G. McGEHEE