


Map No. _____ Sec. 7 Twp. 26 R. 5Well No. 2 Higgins Farm _____
Empire Company

NORTH

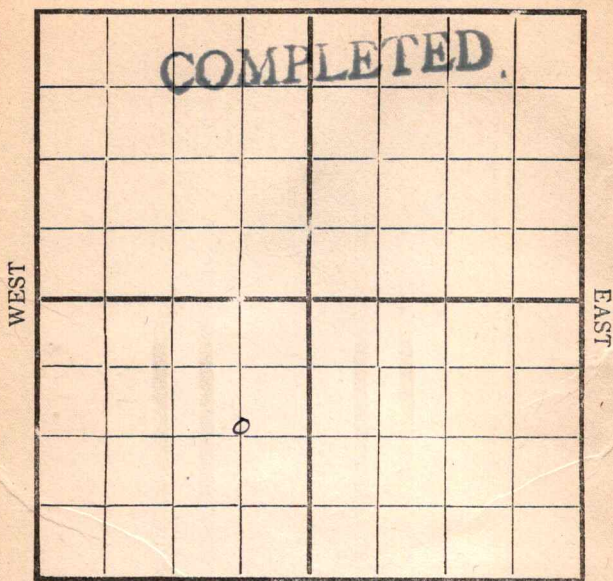

SOUTH

Location _____

Rig Up _____

Drilling Remarks:

Drilling Remarks:

RECORD

Cased _____ in _____ Ft.

Sand _____

Gas _____

Oil _____

Total Depth _____

PRODUCTION

1st 24 hrs. Nat. _____

1st 24 hrs. after shot _____

Gas _____ Cu. Ft.

Dry Hole _____


Abandoned _____

Map No. _____ Sec. 7 Twp. 26 R. 5
 Well No. 2 Higgins Farm _____
Empire Company _____

NORTH

WEST

EAST

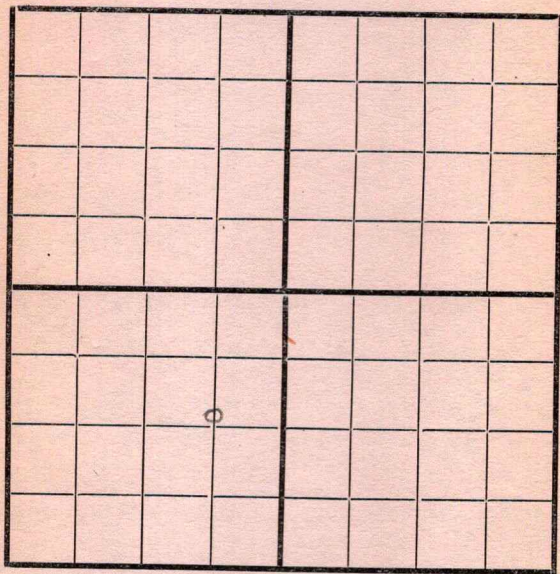

SOUTH

Location _____
 Rig Up ☒ _____
 Drilling and remarks _____

RECORD

Cased _____ in. _____ Ft.
 Sand _____
 Gas _____
 Oil _____
 Total Depth _____

FIRST REPORT

PRODUCTION

1st 24 hrs. Nat. _____
 1st 24 hrs. after shot _____
 Gas _____ Cu. Ft.
 Dry Hole _____
 Abandoned _____

Date


3/5, 1917 Cardiff Scout

Map No. Sec. 7 Twp. 26 R. 5Well No. 2 Higgins FarmEngine Company

NORTH

WEST

EAST

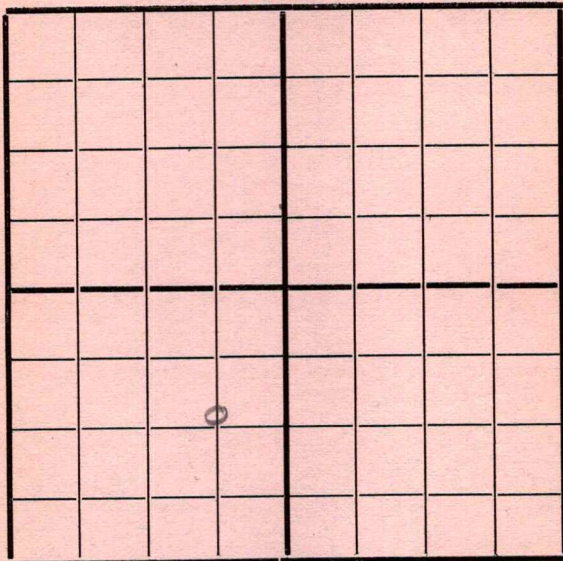

SOUTH

Location

Rig up

Drilling and Remarks:

Rig up

RECORD

Cased in. Ft.

Sand

Gas

Oil

Total Depth

PRODUCTION

1st 24 hrs. Nat.°

1st 24 hrs. after shot

Gas Cu. Ft.

Dry Hole


Abandoned

Date

3/12, 1912, Carley Scout

Map No. _____ Sec. 7 Twp. 26 R. 5
Well No. 2 Higgins Farm _____
Cummins Company _____

NORTH

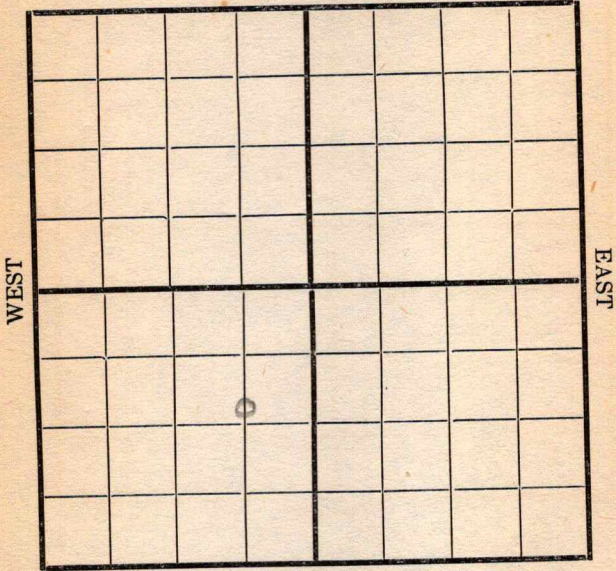

SOUTH

Location _____
Rig Up _____
Drilling and remarks _____

RECORD

Cased _____ in. _____ Ft.
Sand _____
Gas _____
Oil _____
Total Depth _____

PRODUCTION

1st 24 hrs. Nat. _____
1st 24 hrs. after shot _____
Gas _____ Cu. Ft.
Dry Hole _____
Abandoned _____

Date 3/21, 1917 C. C. Card Scout

Map No. _____ Sec. 7 Twp. 26 R. 5
 Well No. 2 Higgins Farm _____
Conjunctive Company _____

NORTH

WEST

EAST

SOUTH

Location _____

Rig Up _____

Drilling and remarks

Rigging up

RECORD

Cased _____ in. _____ Ft.

Sand _____

Gas _____

Oil _____

Total Depth _____

PRODUCTION

1st 24 hrs. Nat. _____

1st 24 hrs. after shot _____

Gas _____ Cu. Ft.


Dry Hole _____

Abandoned _____

Date

3/26 191 7 Conjunctive Scout

Map No. _____ Sec. 7 Twp. 26 R. 5
 Well No. 374 Farm _____
Empire Company _____
 NORTH

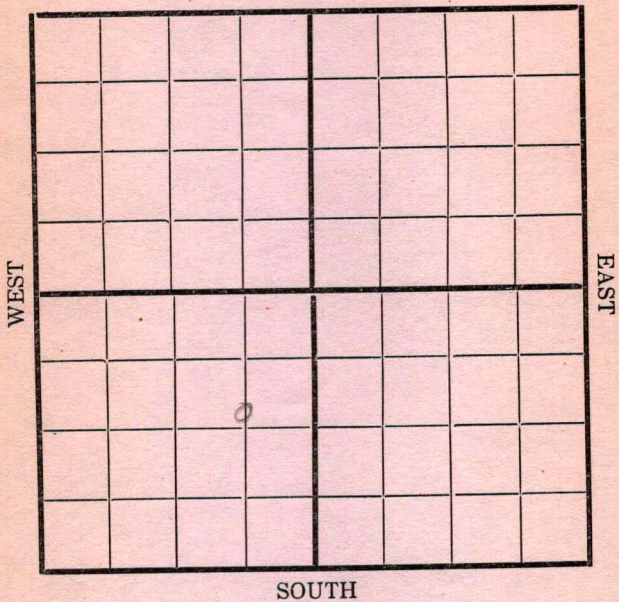

Location _____
 Rig Up _____
 Drilling and remarks _____

Spinning

RECORD

Cased _____ in. _____ Ft.
 Sand _____
 Gas _____
 Oil _____
 Total Depth _____

PRODUCTION

1st 24 hrs. Nat. _____
 1st 24 hrs. after shot _____
 Gas _____ Cu. Ft.
 Dry Hole _____
 Abandoned _____

Date 4/5, 1912 Carl Scout

Map No. _____ Sec. 7 Twp. 26 R. 5
 Well No. 2 Higgins Farm _____
Empire Company _____

NORTH

WEST

EAST

SOUTH

Location _____

Rig Up _____

Drilling and remarks

870

RECORD

Cased _____ in. _____ Ft.

Sand _____

Gas _____

Oil _____

Total Depth _____

PRODUCTION

1st 24 hrs. Nat. _____

1st 24 hrs. after shot _____

Gas _____ Cu. Ft.

Dry Hole _____

Abandoned _____

Date

4/11, 1917 Conley Scout

Map No. _____ Sec. 7 Twp. 26 R. 5
Well No. 2 Higgins _____ Farm
Empire _____ Company

NORTH

WEST

EAST

SOUTH

Location _____
Rig Up _____
Drilling and remarks _____

1000

RECORD


Cased _____ in. _____ Ft.
Sand _____
Gas _____
Oil _____
Total Depth _____

PRODUCTION

1st 24 hrs. Nat. _____
1st 24 hrs. after shot _____
Gas _____ Cu. Ft.
Dry Hole _____
Abandoned _____

Date 4/19, 1917 C. C. C. Scout

Map No. _____ Sec. 7 Twp. 26 R. 5
Well No. 2 Higgins Farm _____
Empire Company _____
NORTH

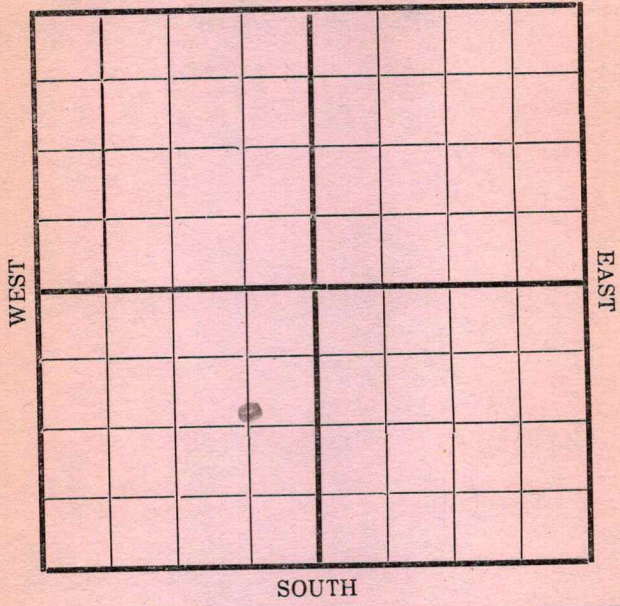


Location _____ Rig Up _____ Drilling and remarks <u>1190</u>	RECORD
	Cased _____ in. _____ Ft.
	Sand _____
	Gas _____
	Oil _____
	Total Depth _____
	PRODUCTION
	1st 24 hrs. Nat. _____
	1st 24 hrs. after shot _____
	Gas _____ Cu. Ft.
	Dry Hole _____
	Abandoned _____

Date _____
APR 26 1917, 191 _____ Scout Carly

Map No. _____ Sec. 7 Twp. 26 R. 5Well No. 2 Higgin Farm __________Emp. Company _____

NORTH

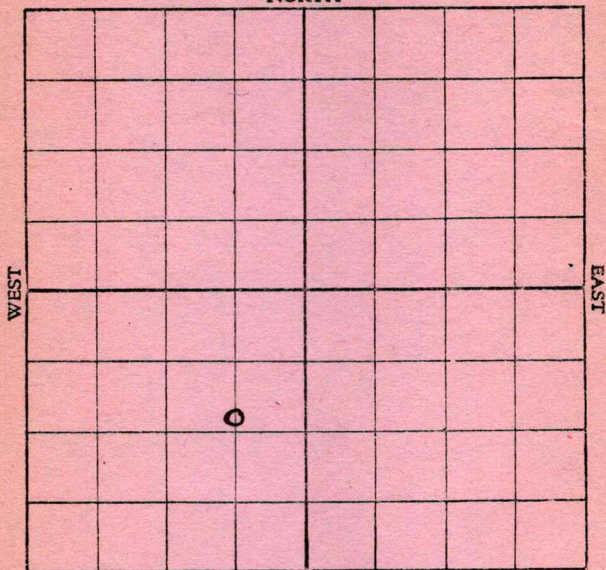

SOUTH

Location _____

Rig up _____

Drilling and remarks:

1190' S.D.

RECORD

Cased _____ in. _____ Ft.

Sand _____

Gas _____

Oil _____

Total Depth _____

PRODUCTION

1st 24 hrs. Nat. _____

1st 24 hrs. after shot _____


Gas _____ Cu. Ft.

Dry Hole _____

Abandoned _____

Date

5/5, 1917, Procker Scout

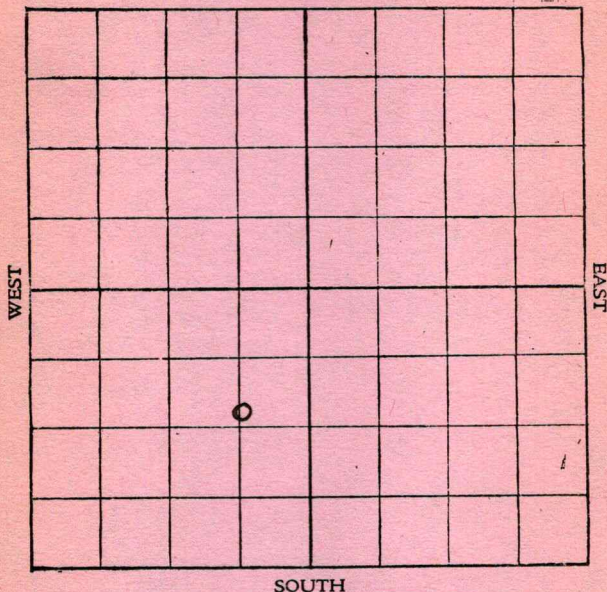Map No. _____ Sec. 7 Twp. 26 R. 5Well No. 2 Higgins Farm __________
Emp. Company
NORTH

Location _____

Rig up _____

Drilling and remarks:

2000'

RECORD

Cased _____ in. _____ Ft.

Sand _____

Gas _____

Oil _____

Total Depth _____

PRODUCTION

1st 24 hrs. Nat. _____

1st 24 hrs. after shot _____

Gas _____ Cu. Ft.


Dry Hole _____

Abandoned _____

Date

5/12, 1917, Crocker Scout

Map No. _____ Sec. 7 Twp. 26 R. 5
 Well No. 2 Higgins Farm _____
Emp. Company _____
 NORTH

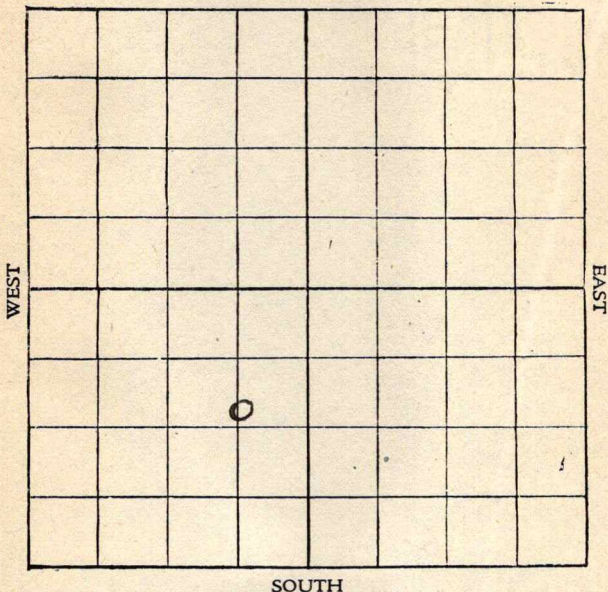

Location _____

Rig up _____

Drilling and remarks:

D. - 23357

RECORD

Cased _____ in. _____ Ft.

Sand _____

Gas _____

Oil _____

Total Depth _____

PRODUCTION

1st 24 hrs. Nat. _____

1st 24 hrs. after shot _____

Gas _____ Cu. Ft.

Dry Hole _____

Abandoned _____

Date


5/19, 1917, Drocker Scout

Map No. _____ Sec. 7 Twp. 26 R. 5

Well No. 2 Higgins Farm _____

_____Emp. Company

NORTH

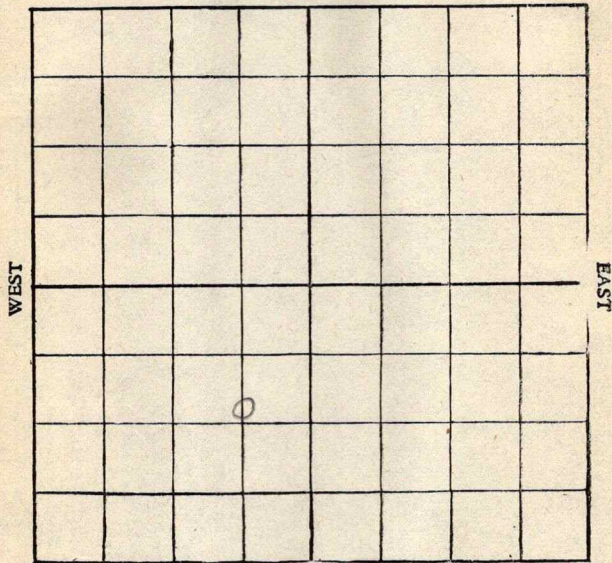

SOUTH

Location _____

Rig up _____

Drilling and remarks:

D.-2388'

RECORD

Cased _____ in. _____ Ft.

Sand _____

Gas _____

Oil _____

Total Depth _____

PRODUCTION

1st 24 hrs. Nat. _____

1st 24 hrs. after shot _____

Gas _____ Cu. Ft.

Dry Hole _____


Abandoned _____

Date _____

5/26, 1917, Lovelace Scout

Map No. _____ Sec. 7 Twp. 26 R. 35
 Well No. 2 Higgins Farm _____
 _____ Emp. Company _____

NORTH

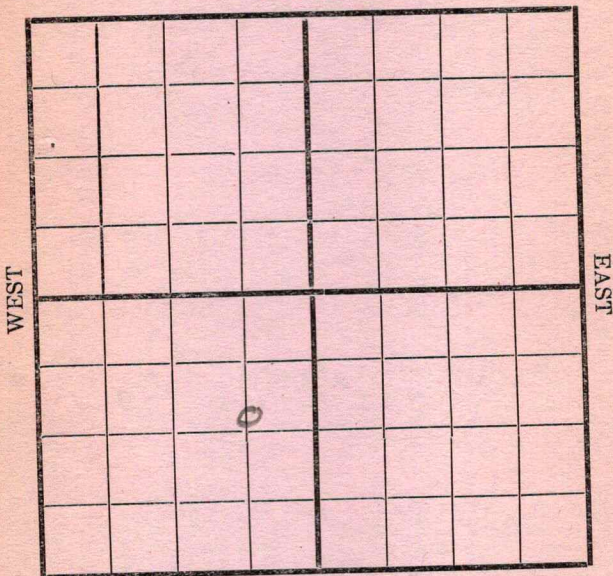

SOUTH

Location _____
 Rig Up _____
 Drilling and remarks _____

Sand 2388'
S.D. 2459'
Hole full
of oil.

RECORD

Cased _____ in. _____ Ft.
 Sand _____
 Gas _____
 Oil _____
 Total Depth _____

PRODUCTION


1st 24 hrs. Nat. _____
 1st 24 hrs. after shot _____
 Gas _____ Cu. Ft.
 Dry Hole _____
 Abandoned _____

Date

6/2 1917 Crocker Scout

Map No. _____ Sec. 7 Twp. 26 R. 5Well No. 2 Higgins Farm __________Emp. Company _____

NORTH

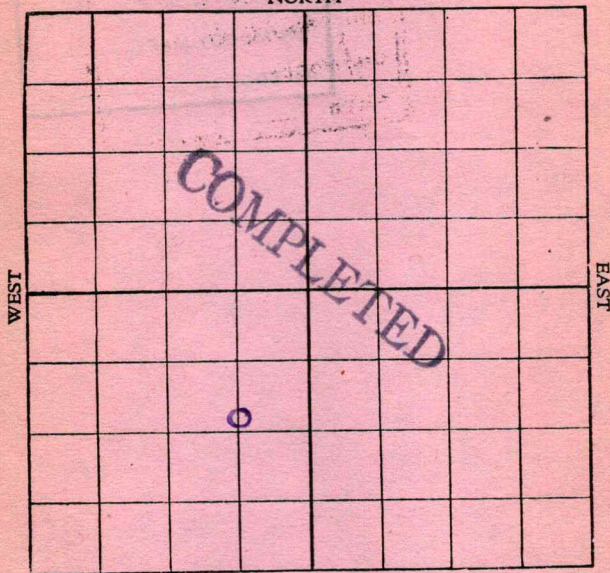

SOUTH

Location _____

Rig up _____

Drilling and remarks:

RECORD

Cased _____ in. _____ Ft.

Sand _____

Gas _____

Oil 2388-2459Total Depth 2459

PRODUCTION

1st 24 hrs. Nat. _____

1st 24 hrs. after shot _____

Gas _____ Cu. Ft.

Dry Hole _____

Abandoned _____

Date

JUN 9 - 1917

191

Scout