

KANSAS


Sedgwick

FORM 51 5M PETROL

Section 22 Township 26 Range 2E

Well No. 1 Stoller (*Stollie*)

Company Texas

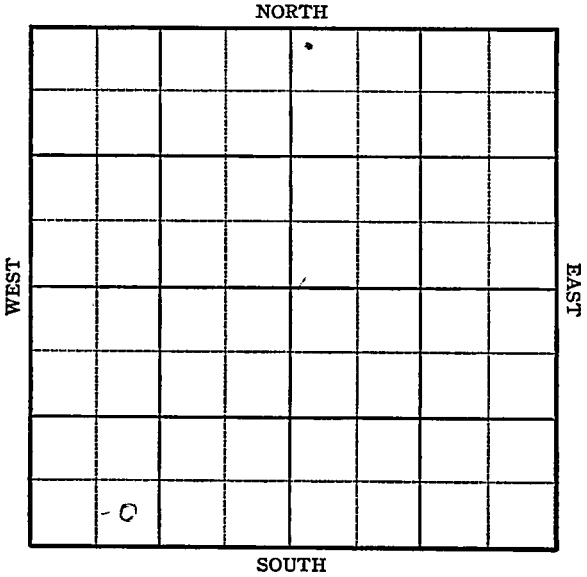

KANSAS

Sedgwick

Sec. 22 Twp. 26 R. 2-E


Well No. #1 Stoller Farm
Texas Company

 Ft. from N. Line

330 Ft. from S. Line

 Ft. from E. Line

990 Ft. from W. Line

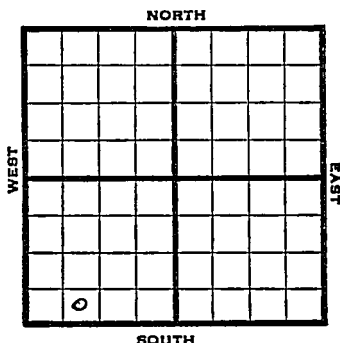

SE SW SW

1945	Elev. 1405	REPORT			
11/14	RU				
11/21	10" @ 190 WOC				
11/28	Drig. 2350°				
12/5	Miss. 2905-2927				
	TD 2927				
	7" @ 2926				
12/12	TD 2931				
	1600' oil plus 600' W in 12 hrs.				
12/20	Pump 31 oil plus 44 water in 4 hrs.				
12/29	" " " "				
1946					
1/10	" " " "				
1/17	" " " "				
1/24	" " " "				
1/30	Miss. 2905				
	7" @ 2926				
	TD 2931				
	Pump 45 oil plus 75 Wtr. Pot.				
	Grav. 36.0				

COMPLETED


KANSASPool Name StollerMap No. 13 Sec. 22 Twp. 26 R. 2EWell No. 1 StollerTexas

Company

FIRST REPORT

Contractor

SE SW SW

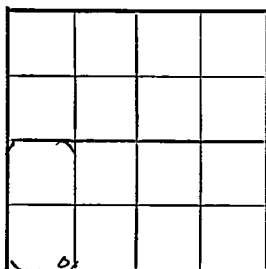SECTION PLAT Ft. from N. Line330 Ft. from S. Line Ft. from E. Line990 Ft. from W. LineSedgwick CountyLocation Rig up

Drilling and Remarks:

RU.

RECORDCased in., ft.Sand Gas Oil Total Depth **PRODUCTION**1st 24 hrs. Nat. 1st 24 hrs. after shot Gas Cu. Ft.Dry Hole Abandoned

Date

NOV 14 1945 19S. J. LEWIS

Scout

KANSAS

Kansas


Pool Name GreenwickMap No. 23 Sec. 22 Twp. 26 R. 2EWell No. 1 StolleiTexas

Company

COMPLETED

Contractor

SE SW SW

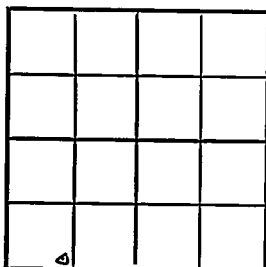E 11405
SECTION PLAT

Ft. from N. Line

330

Ft. from S. Line

Ft. from E. Line

990

Ft. from W. Line

Sedgwick County

Location

Rig up

Drilling and Remarks:

Misc 29057" C 2926Pump 45 oil + 25 W
BY36° ge

RECORD

Cased _____ in., _____ ft.

Sand _____

Gas _____

Oil _____

Total Depth 2931

PRODUCTION

1st 24 hrs. Nat. _____

1st 24 hrs. after shot _____

Gas _____ Cu. Ft.

Dry Hole _____

Abandoned _____

Date

JAN 30 1946 19S. J. LEWIS

Scout