

KANSAS

FORM 51 25M 3-49 PETROL

Sedgwick

Section 29 Township 26- Range 2E

Well No. 2 Sample

Company J.P. Gatty et al

White Cotton

NORTH

WEST

EAST

0							

SOUTH

KANSAS

Sedgwick

Sec. 29 Twp. 26 R. 2E ✓

Well No. #2 Sample Farm

J. P. Gatty Company

White Cotton


990' Ft. from N. Line

Ft. from S. Line

Ft. from E. Line

330' Ft. from W. Line

SW NW NW

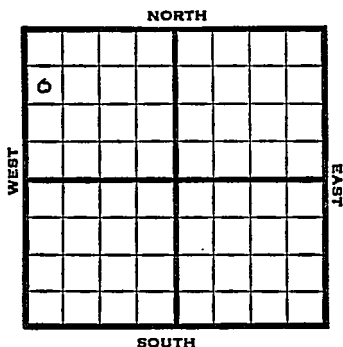

1949

Elev 1383'

R E P O R T

4/27

13" @ 940'
Drlg. 1350'

5/4

KC 2503
10" @ 1560'
Drlg. 2510'

5/10

8" @ 2530'
Drlg. 2680'

5/18

"

5/25

Burgess 2955'
TD 2959'
5" @ 2956'
2800 oil

6/1

"

6/7

"

6/15

Burgess 2955'
5" @ 2956'
TD 2959'
Pump 350 Oil Pot
42° Gr.
Comp

COMPLETED

Map No. _____ Sec. 29 Twp. 26 R. 2E

Well No. 2 Sample _____

_____J. P. Gatty et al._____ Company

_____FIRST REPORT_____ Contractor

SW NW NW

SECTION PLAT

990 Ft. from N. Line

_____ Ft. from S. Line

_____ Ft. from E. Line

330 Ft. from W. Line

o			

Sedgwick County

Location _____

Rig up _____

Drilling and Remarks:

13" @ 940

drlg. 1350

RECORD

Cased _____ in., _____ ft.

Sand _____

Gas _____

Oil _____

Total Depth _____

PRODUCTION

1st 24 hrs. Nat. _____

1st 24 hrs. after shot _____

Gas _____ Cu. Ft.

Dry Hole _____

Abandoned _____

Date

APR 27 1949 19 S. J. LEWIS Scout

Sedgwick County Kansas State
 Map No. K13 Sec. 29 Twp. 26 R. 2E

Well No. 2 Sample

J. P. Gatty et al. Company

COMPLETE

Contractor

SW NW NW

E 11383
 SECTION PLAT

990 Ft. from N. Line

 Ft. from S. Line

 Ft. from E. Line

330 Ft. from W. Line

White Cotton Pool
 Remarks:

Beacon 2955

50 @ 2956

75 @ 2959

Pump 350 oil BT

42°/hr

Date JUN 15 1949

Scout S. J. LEWIS