


Map No. _____ Sec 7 Twp 26 R 5

Well No 5 Higgins Farm _____

Empire Company _____

NORTH

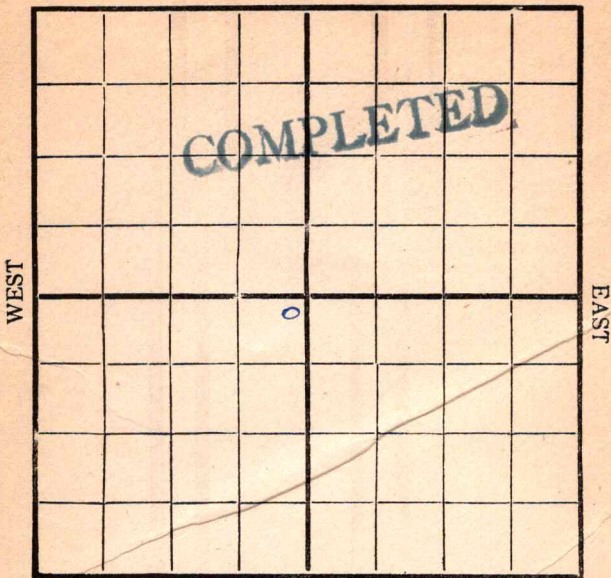

SOUTH

Location _____

Rig Up _____

Drilling Remarks:

Drilling Remarks:

RECORD


PRODUCTION

Cased _____ in _____ Ft.
 Sand _____
 Gas _____
 Oil _____
 Total Depth _____

1st 24 hrs. Nat. _____
 1st 24 hrs. after shot _____
 Gas _____ Cu. Ft.
 Dry Hole _____
 Abandoned _____

Map No. _____ Sec. 7 Twp. 26 R. 5
Well No. 5 Higgins Farm _____
Empire Company _____

NORTH

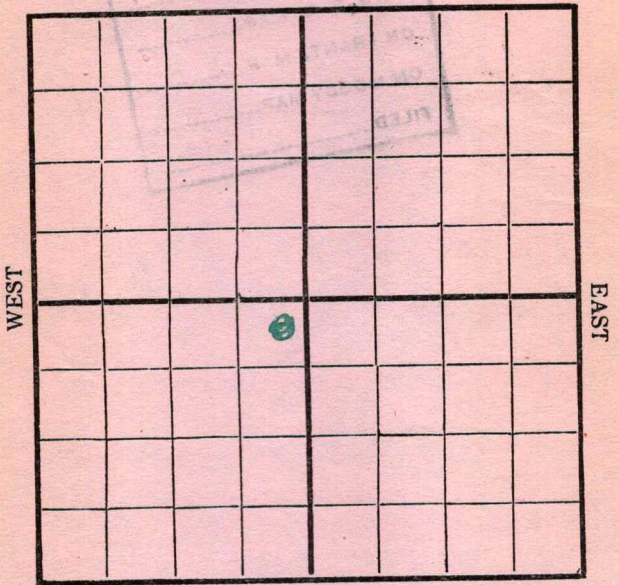

SOUTH

Location _____
Rig Up ☒
Drilling and remarks _____

RECORD

Cased _____ in. _____ Ft.
Sand _____
Gas _____
Oil _____
Total Depth _____

FIRST REPORT

PRODUCTION


1st 24 hrs. Nat. _____
1st 24 hrs. after shot _____
Gas _____ Cu. Ft.
Dry Hole _____
Abandoned _____

Date 4/10, 1917 Carroll Scout

Map No. _____ Sec. 7 Twp. 26 R. 5
 Well No. 57 Higgins Farm _____
Quincy Company _____

NORTH

WEST

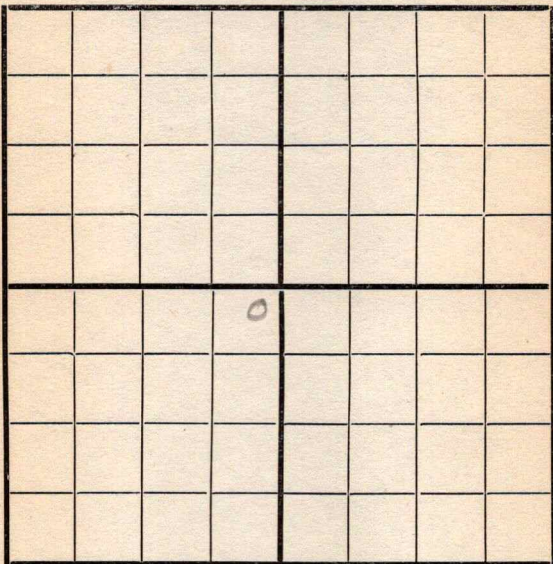

EAST

SOUTH

Location _____
 Rig Up ☒ _____
 Drilling and remarks _____

RECORD

Cased _____ in. _____ Ft.
 Sand _____
 Gas _____
 Oil _____
 Total Depth _____


PRODUCTION

1st 24 hrs. Nat. _____
 1st 24 hrs. after shot _____
 Gas _____ Cu. Ft.
 Dry Hole _____
 Abandoned _____

Date 4/19, 1917 Carlin Scout

Map No. _____ Sec. 7 Twp. 26 R. 5
Well No. 574 Farm _____
Cummins Company _____

NORTH

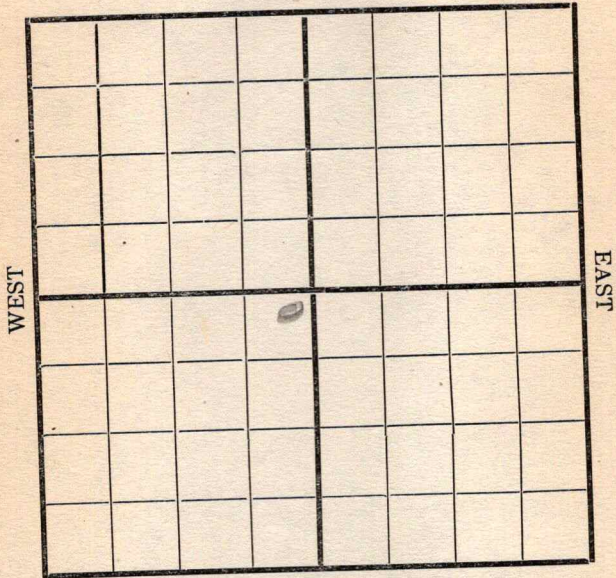

SOUTH

Location _____
Rig Up ✓ _____
Drilling and remarks _____

RECORD
Cased _____ in. _____ Ft.
Sand _____
Gas _____
Oil _____
Total Depth _____

PRODUCTION
1st 24 hrs. Nat. _____
1st 24 hrs. after shot _____
Gas _____ Cu. Ft.
Dry Hole _____
Abandoned _____

Date APR 26 1917
Cummins Scout _____
_____, 191_____

Map No. _____ Sec. 7 Twp. 26 R. 5Well No. 5 Higgins Farm __________
Emp. Company

NORTH

WEST

EAST

SOUTH

Location _____

Rig up _____

Drilling and remarks:

Pay.

RECORD

Cased _____ in. _____ Ft.

Sand _____

Gas _____

Oil _____

Total Depth _____

PRODUCTION

1st 24 hrs. Nat. _____

1st 24 hrs. after shot _____

Gas _____ Cu. Ft.

Dry Hole _____


Abandoned _____

Date

5/5, 1917, Crocker Scout

Map No. _____ Sec. 7 Twp. 26 R. 5Well No. 5 Higgins Farm __________
Emp. Company _____

NORTH

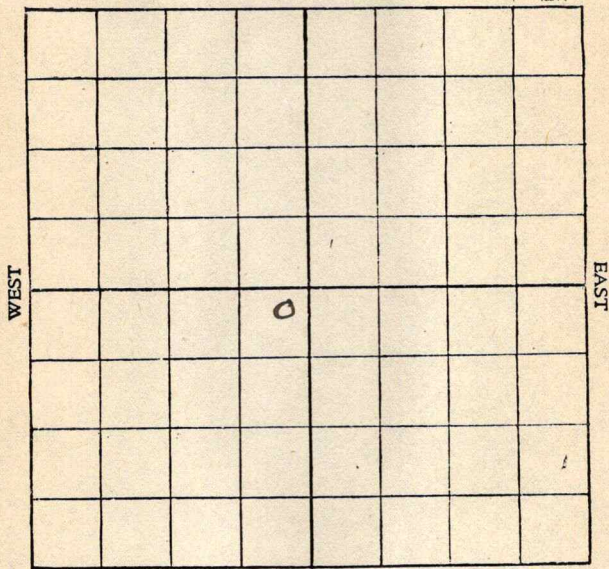

SOUTH

Location _____

Rig up _____

Drilling and remarks:

Rig

RECORD

Cased _____ in. _____ Ft.

Sand _____

Gas _____

Oil _____

Total Depth _____

PRODUCTION

1st 24 hrs. Nat. _____

1st 24 hrs. after shot _____

Gas _____ Cu. Ft.

Dry Hole _____

Abandoned _____

Date

5/12, 1917, Crocker Scout

Map No. _____ Sec. 7 Twp. 26 R. 5
 Well No. 57 Higgin Farm _____
Emp. Company _____
 NORTH

WEST EAST

SOUTH

Location _____

Rig up _____

Drilling and remarks:

Rign up.

RECORD

Cased _____ in. _____ Ft.

Sand _____

Gas _____

Oil _____

Total Depth _____

PRODUCTION

1st 24 hrs. Nat. _____

1st 24 hrs. after shot _____

Gas _____ Cu. Ft.

Dry Hole _____


Abandoned _____

Date

5/14, 1917, Crocker Scout

Map No. _____ Sec. 7 Twp. 26 R. 5Well No. 5 Higgins Farm _____
Emp. Company _____

NORTH

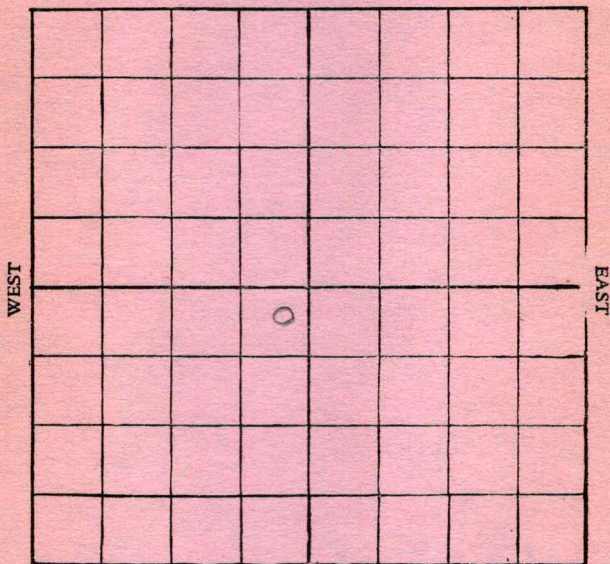

SOUTH

Location _____

Rig up _____

Drilling and remarks:

Spud.

RECORD

Cased _____ in. _____ Ft.

Sand _____

Gas _____

Oil _____

Total Depth _____

PRODUCTION

1st 24 hrs. Nat. _____

1st 24 hrs. after shot _____

Gas _____ Cu. Ft.

Dry Hole _____

Abandoned _____


Date

5/26, 1917, Brocker Scout

Map No. _____ Sec. 7 Twp. 26 R. 5Well No. 3 Higgins Farm _____

Company _____

NORTH

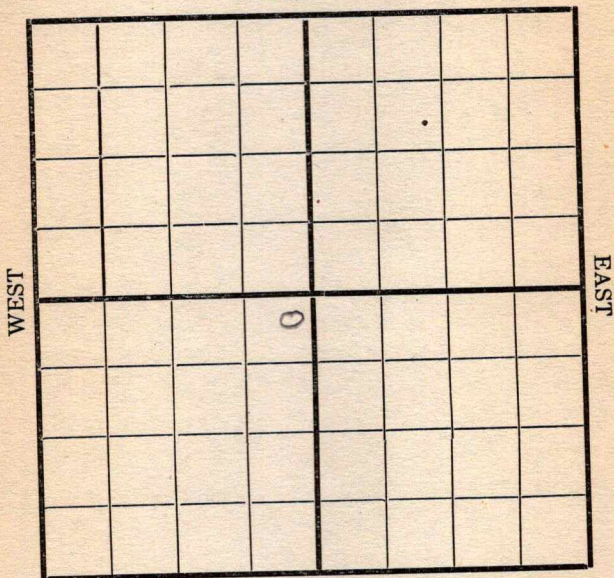

SOUTH

Location _____

Rig Up _____

Drilling and remarks

D-8001

RECORD

Cased _____ in. _____ Ft.

Sand _____

Gas _____

Oil _____

Total Depth _____

PRODUCTION

1st 24 hrs. Nat. _____

1st 24 hrs. after shot _____

Gas _____ Cu. Ft.

Dry Hole _____


Abandoned _____

Date

6/27, 1917Brooker Scout

Map No. _____ Sec. 7 Twp. 26 R. 5
 Well No. 5 Higgins Farm _____
Emp. Company _____

NORTH

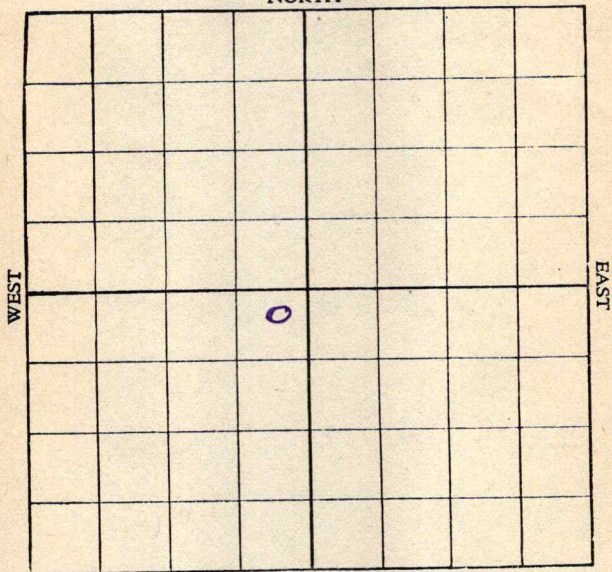

SOUTH

Location _____

Rig up _____

Drilling and remarks:

D-1200

RECORD

Cased _____ in. _____ Ft.

Sand _____

Gas _____

Oil _____

Total Depth _____

PRODUCTION

1st 24 hrs. Nat. _____

1st 24 hrs. after shot _____

Gas _____ Cu. Ft.

Dry Hole _____

Abandoned _____

Date


JUN 9 1917, 191 _____, Scout

Map No. _____ Sec. 7 Twp. 26 R. 5

Well No. 5 Higgins Farm _____

Emp Company _____

NORTH

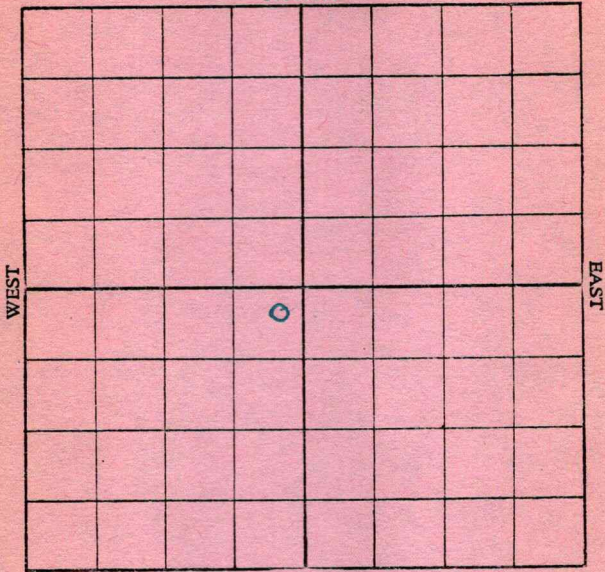

SOUTH

Location _____

Rig up _____

Drilling and remarks:

D-1600

RECORD

Cased _____ in. _____ Ft.

Sand _____

Gas _____

Oil _____

Total Depth _____

PRODUCTION

1st 24 hrs. Nat. _____

1st 24 hrs. after shot _____

Gas _____ Cu. Ft.

Dry Hole _____


Abandoned _____

Date

JUN 16 1917

G. T. Crocker Scout

Map No. _____ Sec. 7 Twp. 26 R. 5
 Well No. 5 Higgins Farm
Empire Company
 NORTH

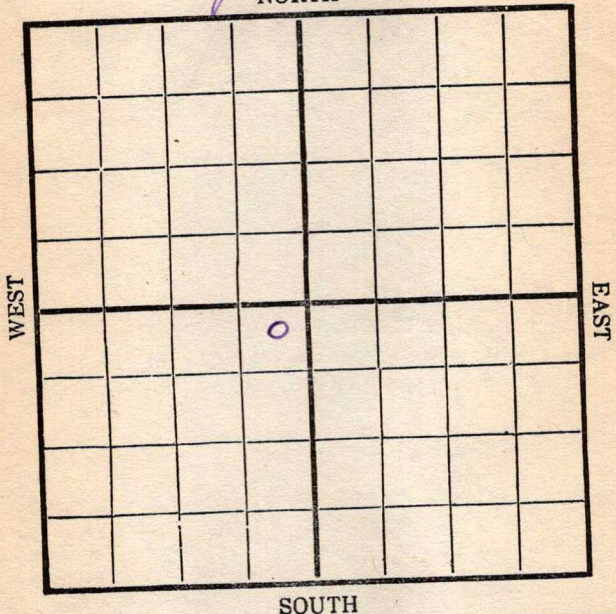

Location _____
 Rig Up _____
 Drilling and remarks
N-2075


RECORD
 Cased _____ in. _____ Ft.
 Sand _____
 Gas _____
 Oil _____
 Total Depth _____

PRODUCTION
 1st 24 hrs. Nat. _____
 First 24 hrs. after shot _____
 Gas _____ Cu. Ft.
 Dry Hole _____
 Abandoned _____

Date _____
B. J. Crocker.
JUN 22, 1917 _____ Scout

Map No. _____ Sec. 7 Twp. 26 R. 5Well No. 5 Haggins FarmEmpire Company

NORTH

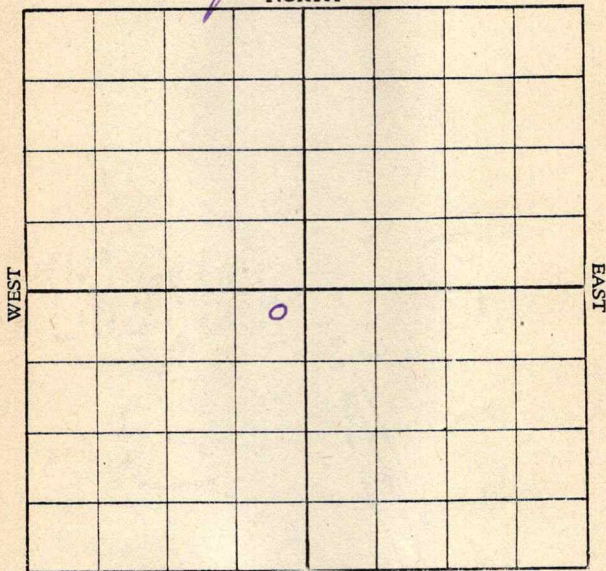

SOUTH

Location _____

Rig up _____

Drilling and remarks:

D-2343'

RECORD

Cased _____ in. _____ Ft.

Sand _____

Gas _____

Oil _____

Total Depth _____

PRODUCTION

1st 24 hrs. Nat. _____

1st 24 hrs. after shot _____

Gas _____ Cu. Ft.

Dry Hole _____

Abandoned _____


Date JUN 30 1917

, 191

Scout

Map No. _____ Sec. 7 Twp. 26 R. 5
 Well No. 5 Higgins Farm _____
 _____ Emp. Company

NORTH

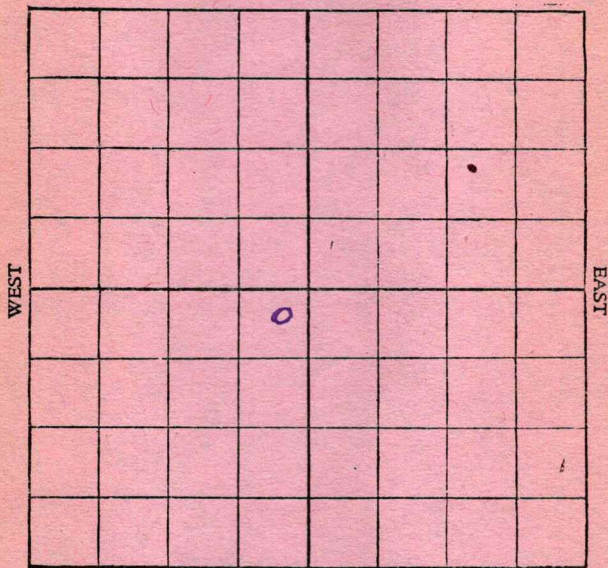

SOUTH

Location _____

Rig up _____

Drilling and remarks:

J.S. 2412'
D-2477'

RECORD

Cased _____ in. _____ Ft.

Sand _____

Gas _____

Oil _____

Total Depth _____

PRODUCTION

1st 24 hrs. Nat. _____

1st 24 hrs. after shot _____

Gas _____ Cu. Ft.

Dry Hole _____


Abandoned _____

Date

JUL 7 1917

C. J. Crocker
 Scout

Map No. _____ Sec. 7 Twp. 26 R. 5
 Well No. 5 Higgins Farm
Empire Company

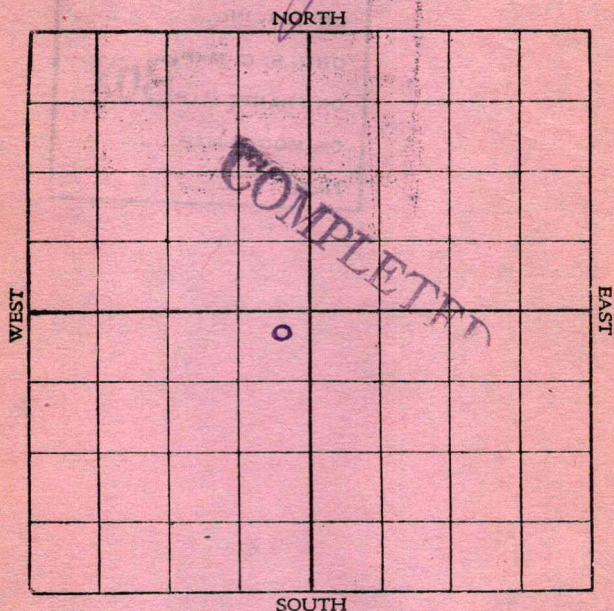

Location _____

Rig up _____

Drilling and remarks:

RECORD

Cased _____ in. _____ Ft.

Sand 2412-2487

Gas _____

Oil 75 bbls.Total Depth 2487

PRODUCTION

1st 24 hrs. Nat. _____

1st 24 hrs. after shot _____

Gas _____ Cu. Ft.

Dry Hole _____

Abandoned _____

Date

JUL 14 1917

C. J. Crocker
 Scout