


Map No. _____ Sec. 7 Twp. 26 R. 5Well No. 20 Hull + Higgins Farm _____Empire Company _____

NORTH

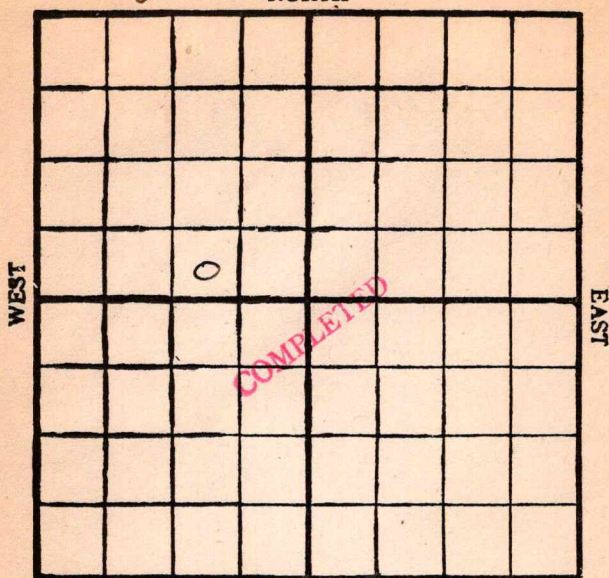

SOUTH

Location _____

Rig Up _____

Drilling Remarks:

Drilling Remarks:

RECORD

Cased _____ in. _____ ft.

Sand _____

Gas _____

Oil _____

Total Depth _____

PRODUCTION

1st 24 hrs. Nat. _____

1st 24 hrs. after shot _____

Gas _____ cu. ft.

Dry Hole _____

Abandoned _____

Map No. K14 Sec. 7 Twp. 26 R. 5Well No. 20 Hull & HigginsEmpire Company

Contractor

NORTH

WEST

EAST

FIRST REPORT

SOUTH

986 E

250 S

Location _____

Rig up ☒

Drilling and Remarks:

RECORD

Cased _____ in., _____ ft.

Sand _____

Gas _____

Oil _____

Total Depth _____

PRODUCTION

1st 24 hrs. Nat. _____

1st 24 hrs. after shot _____

Gas _____ Cu. Ft.

Dry Hole _____

Abandoned _____

Date

191

9

Cyle

Scout

3/27

Map No. K14 Sec. 7 Twp. 26 R. 5
 Well No. 20 Hull & Higgins
Empire Company
 Contractor

NORTH

WEST

EAST

COMPLETED

SOUTH

986 E

250 S

Location _____

Rig up _____

Drilling and Remarks:

RECORD

Cased _____ in., _____ ft.

Sand 2392-2462

Gas _____

Oil _____

Total Depth _____

PRODUCTION

1st 24 hrs. Nat. 50 bbl

1st 24 hrs. after shot _____

Gas _____ Cu. Ft.

Dry Hole _____

Abandoned _____

Date

191 9

Scout

5/20

Pyle