
FORM 51 25M 8-50 WESTERN Sedgwick **KANSAS**

Section 29 Township 26 Range 2E

Well No. #1 Jansen

Company J. P. Gaty

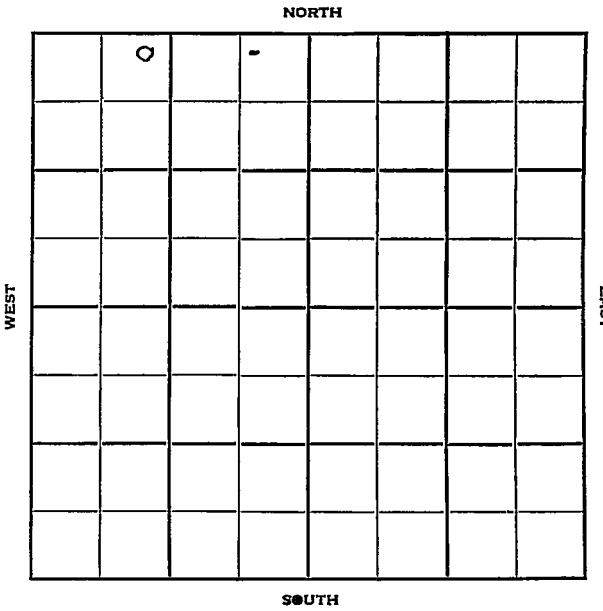

FORM 252-B
10M 10-50 PETROL

Sedgwick KANSAS

Sec. 29 Twp. 26 R. 2 E

Well No. # 1 Jansen Farm

J. P. Gaty Company

Contractor


120 Ft. from N. Line

Ft. from S. Line

Ft. from E. Line

1080 Ft. from W. Line

NE NW NW

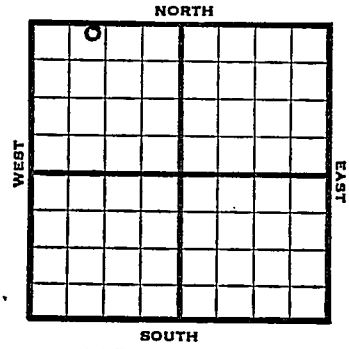

1952	Elev. 1395' REPORT
1/16	Location
1/30	Aband. Location
	ABANDONED

FORM 275 FOR SALE BY KANSAS BLUE PRINT CO.


County Sedgwick State Kansas

Sec. 29 (Blk. Twp.) 26 (Sur. Rge.) 2E Map No.

Operator J. P. Gaty

Well No. 1 Farm Jansen

Elev. 1395 Location NE NW NW

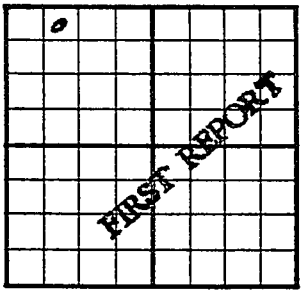

120 Ft. From N Line NW

1080 Ft. From W Line Quarter

1st. Report JAN 16 1952

Completion

Remarks

Spudding Date

Drlg. Data

J. E. TYRA

FORM 275 FOR SALE BY KANSAS BLUE PRINT CO.


County Sedgwick State Kansas

Sec. 29 (Blk. Twp.) 26 (Sur. Rge.) 2E Map No.

Operator J. P. Gatty

Well No. 1 Farm Jansen

Elev. 1395 Location NE NW NW

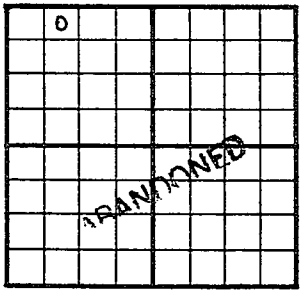

120 Ft. From N Line NW

1080 Ft. From W Line Quarter

1st. Report

Completion JAN 30 1952

Remarks

Spudding Date

Drlg. Data

Abd. location

J. G. McGEHEE