

Section 19 Township 26 Range 2E
Well No. #2 Tjaden (Tjaden)
Company J. P. Gatty

							0

NORTH

WEST

EAST

SOUTH

Sedgwick

KANSAS

Sec. 19 Twp. 26 R. 2E

Well No. #2 Tajden Farm

J. P. Gatty

Company

Miscellaneous (Morrison Drlg. Contr.)

Ft. from N. Line

330'


Ft. from S. Line

330'

Ft. from E. Line

Ft. from W. Line

SE/C

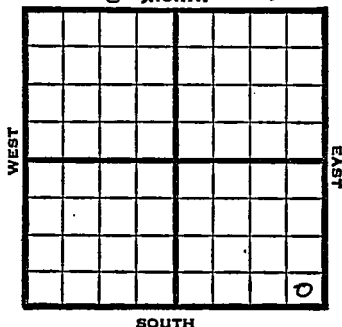

1949

Elev 1378' REPORT

12/21 10" @ 112'

12/28 TD 2937'
7" @ 2937'

1950

2/1

TD 2948'
10" @ 112'
7" @ 2937'
Burgess 2937'
P 166 BOPD
Comp

COMPLETED

Map No. _____ Sec. 19 Twp. 26 R. 2E

Well No. 2 Taiden

J. P. Gatty Company

Morrison Drlg. Contractor

SE/C


FIRST REPORT
SECTION PLAT

_____ Ft. from N. Line

330 Ft. from S. Line

330 Ft. from E. Line

_____ Ft. from W. Line

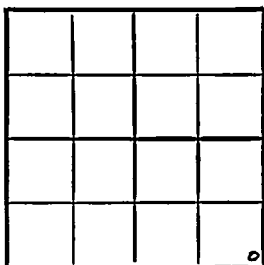

Sedgwick County

Location _____

Rig up _____

Drilling and Remarks:

10" @ .112

RECORD

Cased _____ in. _____ ft.

Sand _____

Gas _____

Oil _____

Total Depth _____

PRODUCTION

1st 24 hrs. Nat. _____

1st 24 hrs. after shot _____

Gas _____ Cu. Ft.

Dry Hole _____

Abandoned _____

Date

DEC 21 1949 19 S. J. LEWIS Scout

Kansas

Miscellaneous

Map No. _____ Sec. 19 Twp. 26 R. 2EWell No. 2 Tjaden_____
J. P. Gatty _____ Company_____
SE/C _____ ContractorEl. 1378
SECTION PLAT_____
Ft. from N. Line330 Ft. from S. Line330 Ft. from E. Line_____
Ft. from W. Line

COMPLETE			
			o

Sedgwick County

Location _____

Rig up _____

Drilling and Remarks:

10" @ 1127" @ 2937Burgess - 2937P 166 BOPD✓

RECORD

Cased _____ in., _____ ft.

Sand _____

Gas _____

Oil _____

Total Depth 2948

PRODUCTION

1st 24 hrs. Nat. _____

1st 24 hrs. after shot _____

Gas _____ Cu. Ft.

Dry Hole _____

Abandoned _____

Date

FEB 1 1950

19

J. E. TYRA

Scout