


Russell
 County
 Berry
 Farm
 Southern Oil Corp
 Company
 No. 1
 Sec. 0
 Township 15 S
 Range 13 W
 Section 33
 Elev. _____ T.D. 3336'
 Date Drilled 1-8-36
 Correlation by _____
 Prod. 391 B.

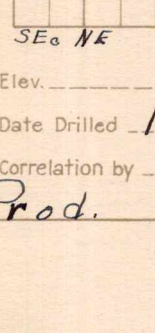

Twp.

6	5	4	3	2	1
7	8	9	10	11	12
18	17	16	15	14	13
19	20	21	22	23	24
30	29	28	27	26	25
31	32	33	34	35	36

