


Map No. _____ Sec. 7 Twp. 26 R. 5Well No. 5 Anderson Farm __________Empire_____
Company

NORTH

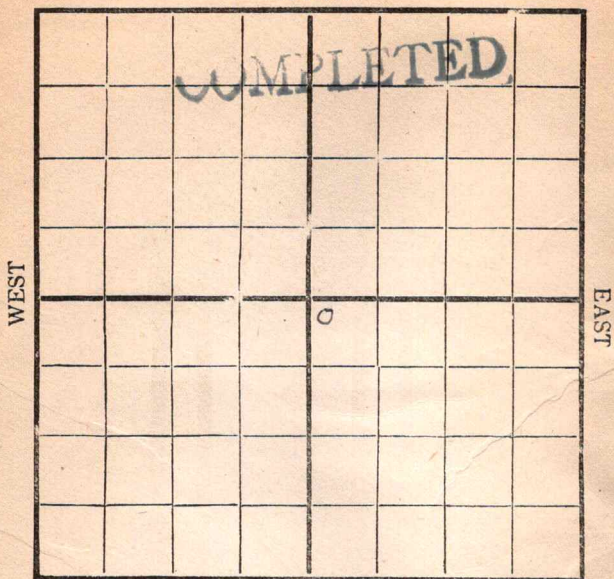

SOUTH

Location _____

Rig Up _____

Drilling Remarks:

Drilling Remarks:

RECORD

PRODUCTION

Cased _____ in _____ Ft.

1st 24 hrs. Nat. _____

Sand _____

1st 24 hrs. after shot _____

Gas _____

Gas _____ Cu. Ft.

Oil _____

Dry Hole _____

Total Depth _____


Abandoned _____

Map No. _____ Sec. 7 Twp. 26 R. 5
 Well No. 5 Anderson Farm
Engine Company

NORTH

WEST

EAST

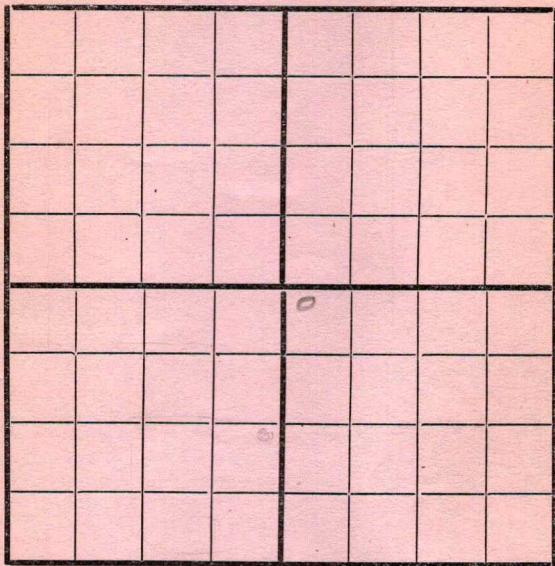

SOUTH

Location _____
 Rig Up _____
 Drilling and remarks _____

RECORD

Cased _____ in. _____ Ft.
 Sand _____
 Gas _____
 Oil _____
 Total Depth _____

FIRST REPORT


PRODUCTION

1st 24 hrs. Nat. _____
 1st 24 hrs. after shot _____
 Gas _____ Cu. Ft.
 Dry Hole _____
 Abandoned _____

Date

3/5, 191 7 Condiff Scout

Map No. _____ Sec. 7 Twp. 26 R. 5
 Well No. 5 Anderson Farm
Empire Company

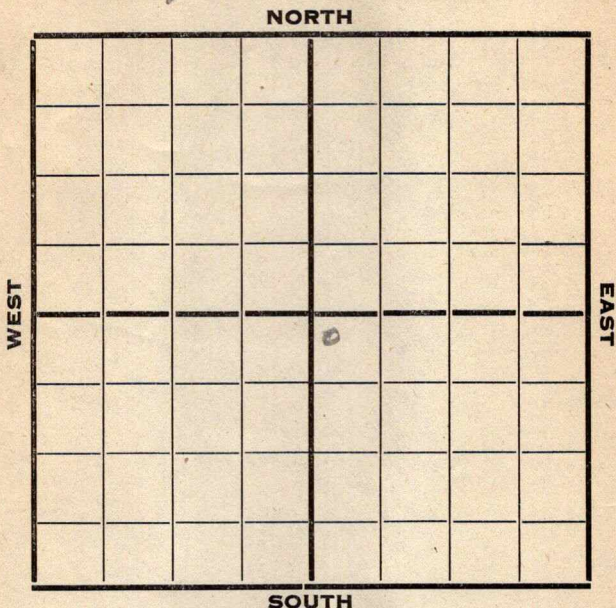

Location _____

Rig up _____

Drilling and Remarks:

Rig up

RECORD

Cased _____ in. _____ Ft.

Sand _____

Gas _____

Oil _____

Total Depth _____

PRODUCTION

1st 24 hrs. Nat. _____

1st 24 hrs. after shot _____

Gas _____ Cu. Ft.

Dry Hole _____


Abandoned _____

Date

3/2, 1917, Carly Scout

Map No. _____ Sec. 7 Twp. 26 R. 5
Well No. 5012 Farm _____
Engine Company _____

NORTH

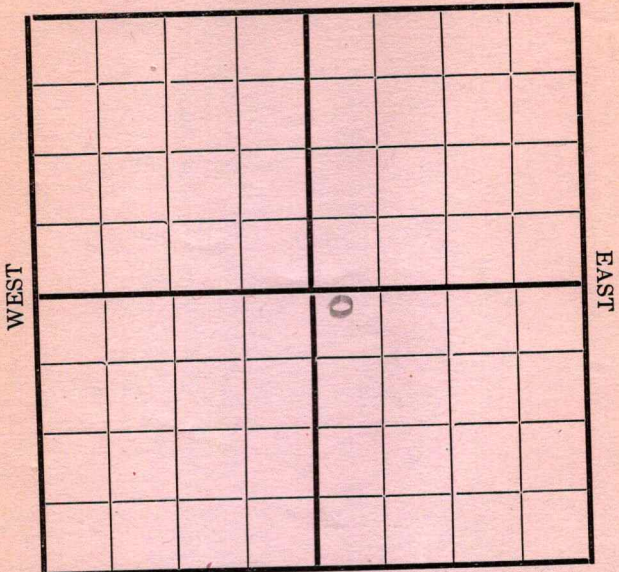

SOUTH

Location _____
Rig Up _____
Drilling and remarks _____

RECORD

Cased _____ in. _____ Ft.
Sand _____
Gas _____
Oil _____
Total Depth _____


PRODUCTION

1st 24 hrs. Nat. _____
1st 24 hrs. after shot _____
Gas _____ Cu. Ft.
Dry Hole _____
Abandoned _____

Date 3/21, 1917 Carley Scout

Map No. _____ Sec. 7 Twp. 26 R. 5
 Well No. 5 Anderson Farm
Engine Company

NORTH

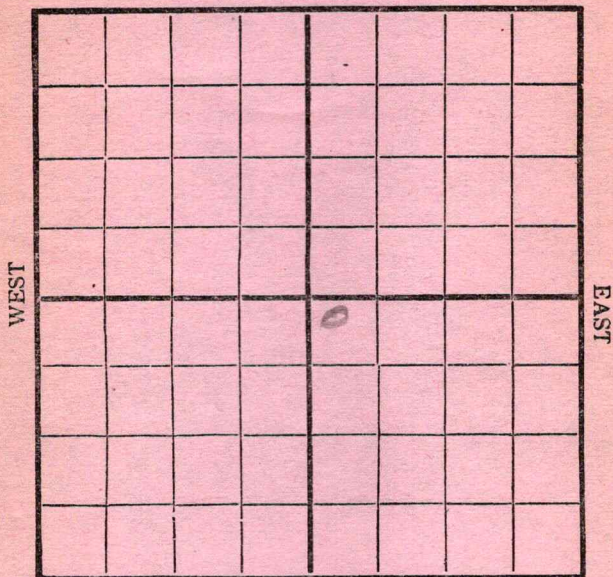

SOUTH


REMARKS:

Rigging up

Date

3/26, 1912 Conley Scout

Map No. _____ Sec. 7 Twp. 26 R. 5
 Well No. 5 Anderson Farm _____
Empire Company _____
 NORTH

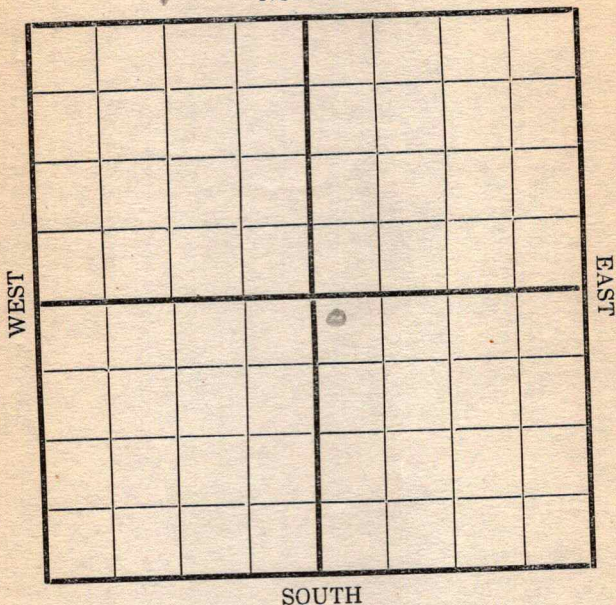

SOUTH

Location _____

Rig Up _____

Drilling and remarks

Rigged up

RECORD

Cased _____ in. _____ Ft.

Sand _____

Gas _____

Oil _____

Total Depth _____

PRODUCTION

1st 24 hrs. Nat. _____

1st 24 hrs. after shot _____

Gas _____ Cu. Ft.


Dry Hole _____

Abandoned _____

Date

4/5, 191 7 *Carley* Scout

Map No. _____ Sec. 7 Twp. 26 R. 5
Well No. 5 Anderson Farm _____
Empire Company _____

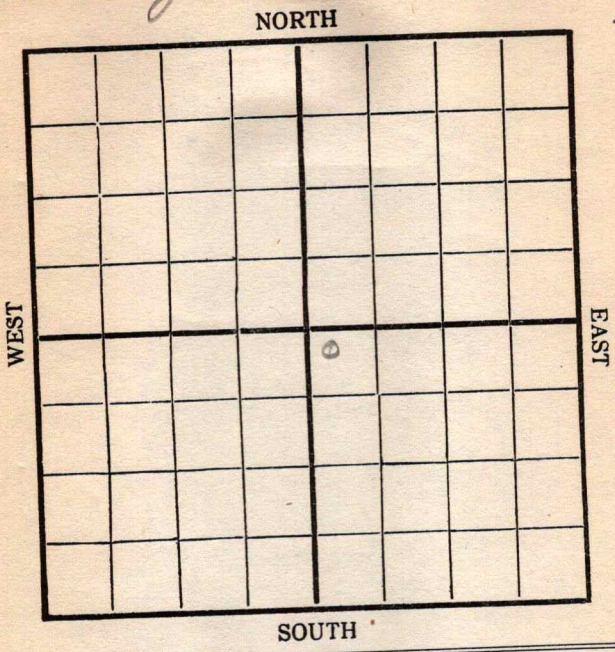

Location _____
Rig Up _____
Drilling and remarks _____
Rigged up

RECORD

Cased _____ in. _____ Ft.
Sand _____
Gas _____
Oil _____
Total Depth _____

PRODUCTION

1st 24 hrs. Nat. _____
1st 24 hrs. after shot _____
Gas _____ Cu. Ft.
Dry Hole _____
Abandoned _____

Date 4/11, 1917 Empire Scout _____

Map No. _____ Sec. 7 Twp. 26 R. 5Well No. 5 Anderson Farm _____Company Empire _____

NORTH

WEST

EAST

SOUTH

Location _____

Rig Up _____

Drilling and remarks

RECORD

Cased _____ in. _____ Ft.

Sand _____

Gas _____

Oil _____

Total Depth _____

PRODUCTION

1st 24 hrs. Nat. _____

1st 24 hrs. after shot _____

Gas _____ Cu. Ft.

Dry Hole _____

Abandoned _____


Date

191

Scout

Map No. _____ Sec. 7 Twp. 26 R. 5
 Well No. 5 Anderson Farm
Empire Company

NORTH

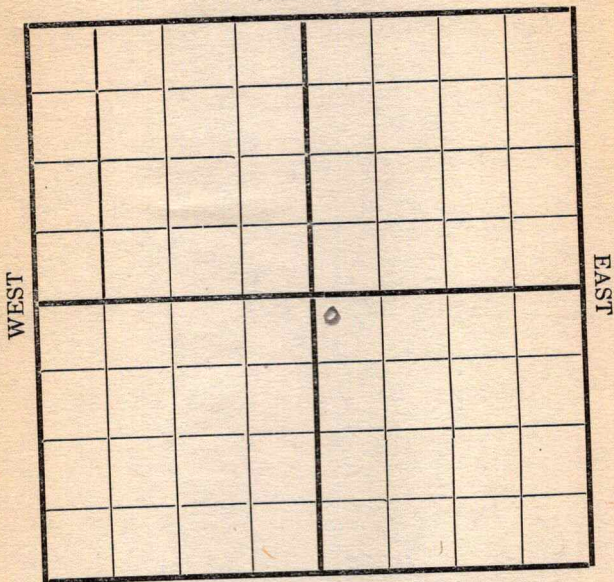

SOUTH

Location _____
 Rig Up _____
 Drilling and remarks

475

RECORD

Cased _____ in. _____ Ft.
 Sand _____
 Gas _____
 Oil _____
 Total Depth _____

PRODUCTION

1st 24 hrs. Nat. _____
 1st 24 hrs. after shot _____
 Gas _____ Cu. Ft.
 Dry Hole _____
 Abandoned _____

Date

4/26 191 2 Conley Scout

Map No. _____ Sec. 7 Twp. 26 R. 5
 Well No. 5 Andersson Farm _____
 _____ Emp. Company _____

NORTH

WEST

EAST

SOUTH

Location _____

Rig up _____

Drilling and remarks:

D, - 9-70'

RECORD

Cased _____ in. _____ Ft.

Sand _____

Gas _____

Oil _____

Total Depth _____

PRODUCTION

1st 24 hrs. Nat. _____

1st 24 hrs. after shot _____

Gas _____ Cu. Ft.

Dry Hole _____

Abandoned _____

Date

5/5, 1917, Procker Scout

Map No. _____ Sec. 7 Twp. 26 R. 5
 Well No. 5 Anderson Farm
Emp. Company
 NORTH

				0			

WEST EAST

SOUTH

Location _____

Rig up _____

Drilling and remarks:

D-1400'

RECORD

Cased _____ in. _____ Ft.

Sand _____

Gas _____

Oil _____

Total Depth _____

PRODUCTION

1st 24 hrs. Nat. _____

1st 24 hrs. after shot _____

Gas _____ Cu. Ft.

Dry Hole _____

Abandoned _____

Date

5/12, 7, Crocker Scout

Map No. _____ Sec. 7 Twp. 26 R. 5

Well No. 5 Anderson Farm _____

_____ Emp. Company _____

NORTH

				0			

WEST

EAST

SOUTH

Location _____

Rig up _____

Drilling and remarks:

I-2060!
Set 8 1/2" Casing

RECORD

Cased _____ in. _____ Ft.

Sand _____

Gas _____

Oil _____

Total Depth _____

PRODUCTION

1st 24 hrs. Nat. _____

1st 24 hrs. after shot _____

Gas _____ Cu. Ft.

Dry Hole _____

Abandoned _____


Date

726.7, Coroker Scout

Map No. _____ Sec. 7 Twp. 26 R. 5
 Well No. 5 Anderson Farm _____
 _____ Emp Company _____

NORTH

WEST

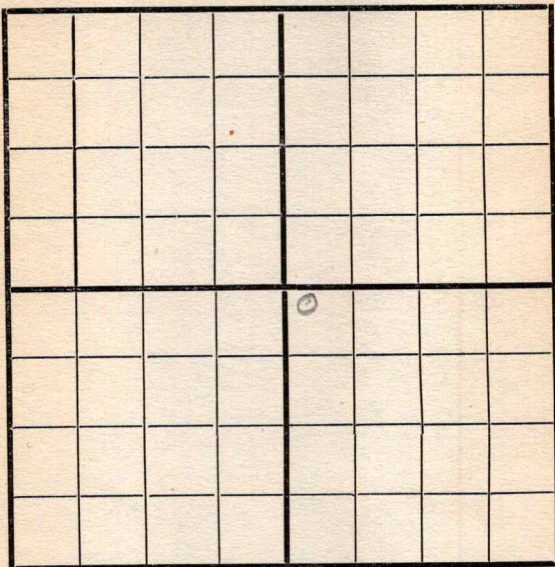

EAST

SOUTH

Location _____
 Rig Up _____
 Drilling and remarks _____

T. Sand 2400'
S.D. for 6 3/8
ceg. no show
of oil.

RECORD

Cased _____ in. _____ Ft.
 Sand _____
 Gas _____
 Oil _____
 Total Depth _____

PRODUCTION

1st 24 hrs. Nat. _____
 1st 24 hrs. after shot _____
 Gas _____ Cu. Ft.
 Dry Hole _____
 Abandoned _____

Date

6/2, 1917 Crocker Scout

Map No. _____ Sec. 7 Twp. 26 R. 5
 Well No. 5 Anderson Farm _____
Emp. Company _____

NORTH

WEST

EAST

SOUTH

Location _____

Rig up _____

Drilling and remarks:

I.S. 2400'
I.D. for 6"
Case

RECORD

Cased _____ in. _____ Ft.

Sand _____

Gas _____

Oil _____

Total Depth _____

PRODUCTION

1st 24 hrs. Nat. _____

1st 24 hrs. after shot _____

Gas _____ Cu. Ft.

Dry Hole _____

Abandoned _____


Date

JUN 9 - 1917
 _____, 191____

G. T. Crocker
 _____ Scout

Map No. _____ Sec. 7 Twp. 26 R. 5Well No. 5-Anderson Farm __________
Emp. Company _____

NORTH

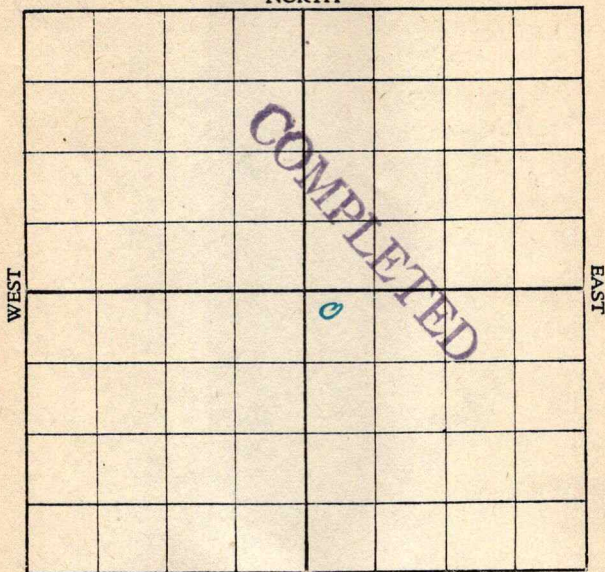

SOUTH

Location _____

Rig up _____

Drilling and remarks:

*Est.
75 bbls.*

RECORD

Cased _____ in. _____ Ft.

Sand _____

Gas _____

Oil 2404 - 2486Total Depth 2486

PRODUCTION

1st 24 hrs. Nat. _____

1st 24 hrs. after shot _____

Gas _____ Cu. Ft.

Dry Hole _____

Abandoned _____

Date

JUN 16 1917

, 191

E. J. Crocker
Scout